


# T. 7 S. R. 5 W. W.M.

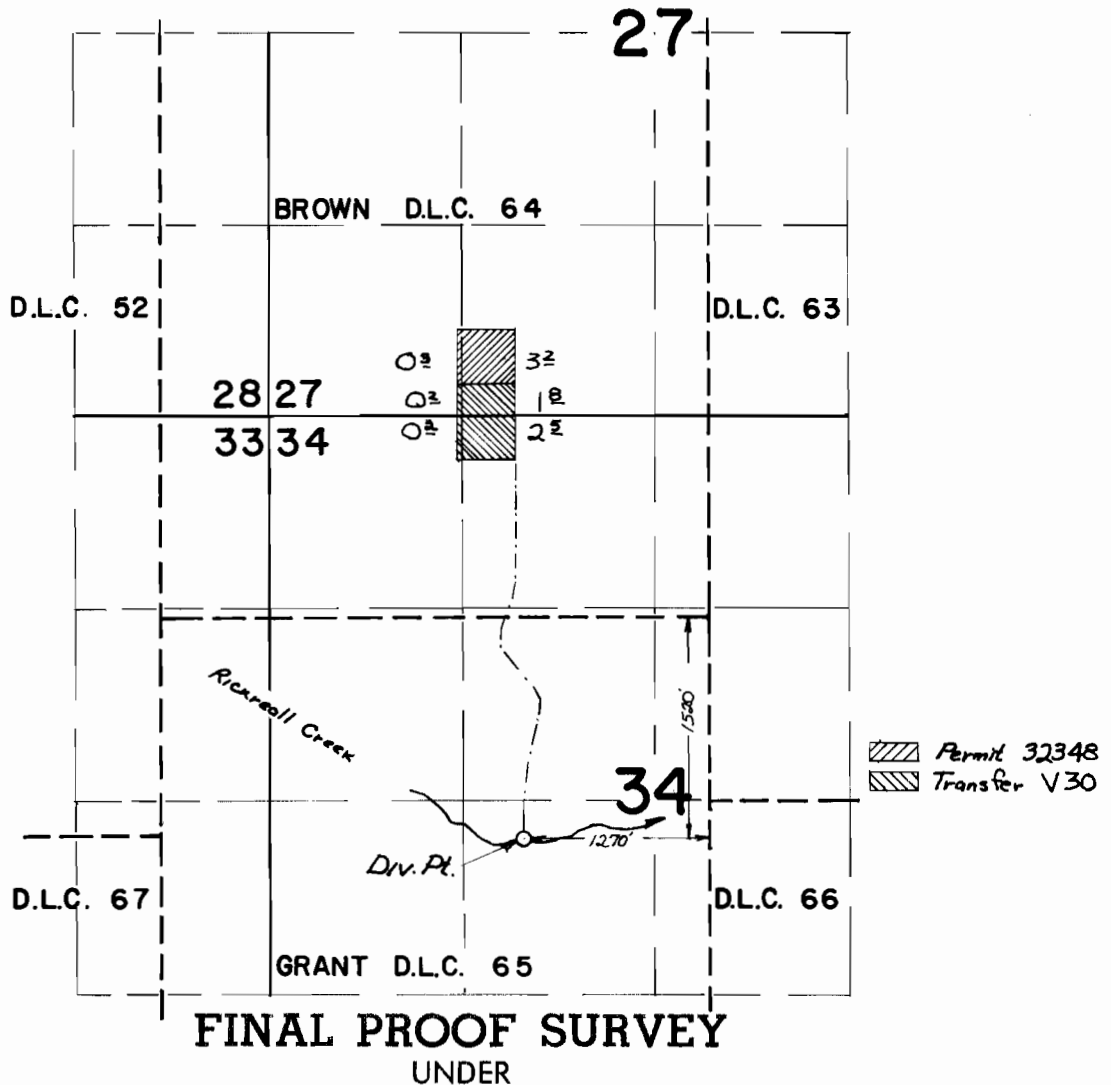

Application No. 43283      TRANSFER V 30  
 Permit No. 32348  
 IN NAME OF

**A. C. VOTH**

Surveyed 1 JULY 1969, by D. R. BUELL