


T. 9 S. R. 6 W. W.M.

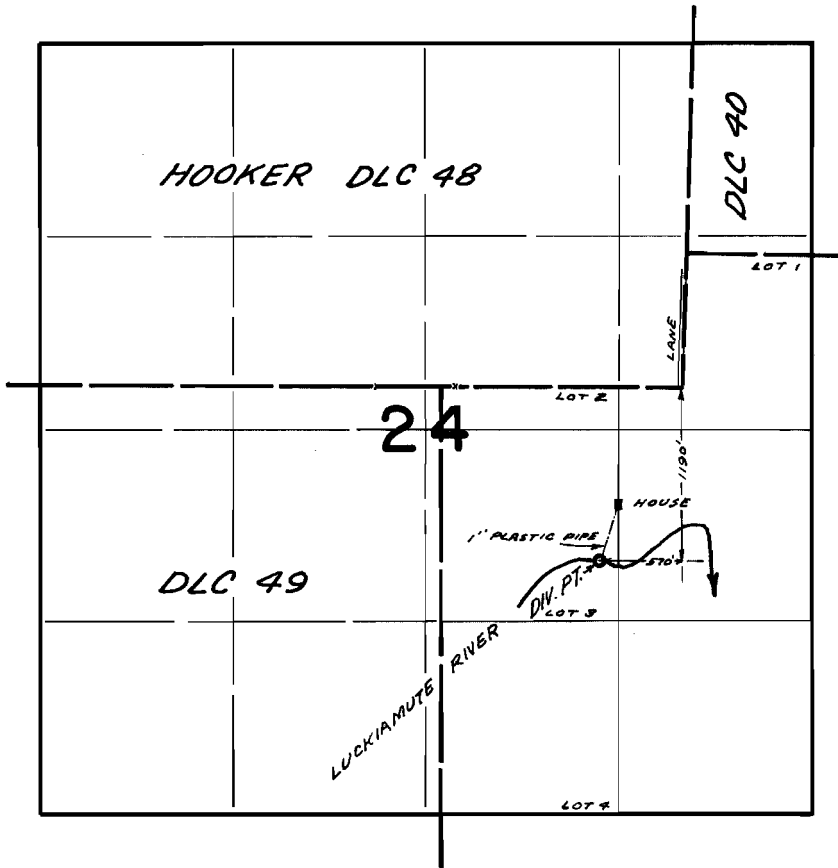

**FINAL PROOF SURVEY**  
UNDER

Application No. 44634 Permit No. 33122  
IN NAME OF

FRANK B. DOLL

Surveyed MAR. 31, 1969, by D. BUELL