


G-2596
36918

T.4N.R.29E.W.M.

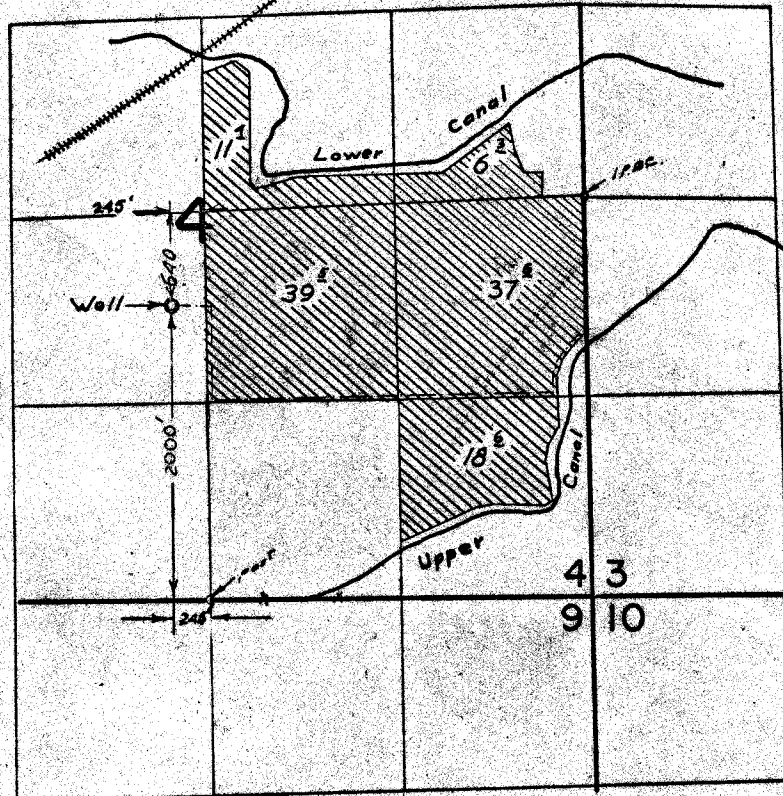

FINAL PROOF SURVEY UNDER

Application No. G-2763 Permit No. G-2596
IN NAME OF

JOHN F. WALCHLI

Surveyed July 15, 1969, by L.E. Gould