


T. 1 N. R. 38 E. W.M.

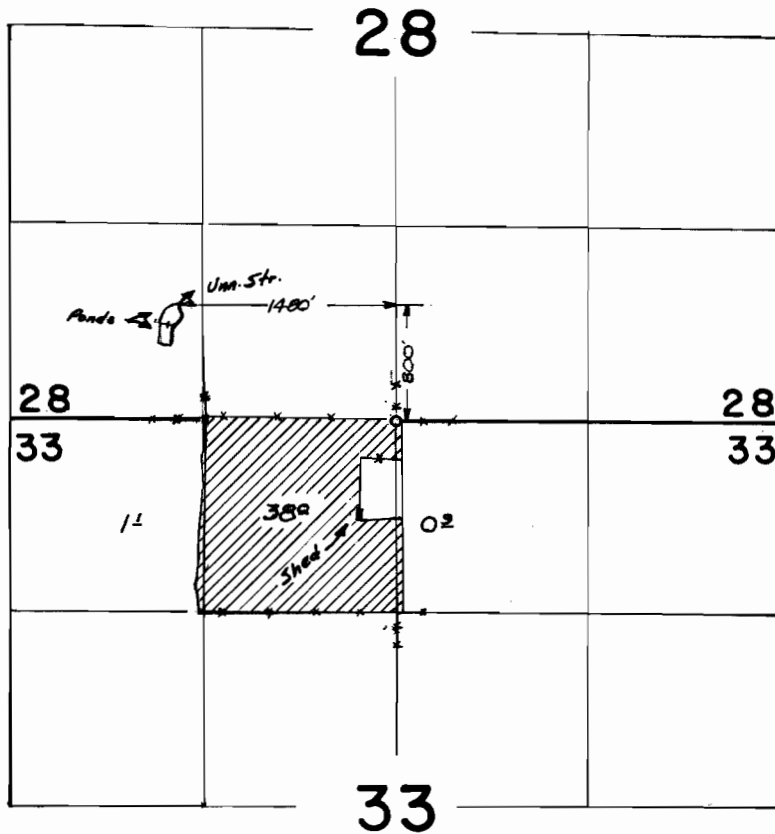

FINAL PROOF SURVEY
UNDER

R 41200 R 4652
Application No. 41519 Permit No. 30843
IN NAME OF

JOE W. JARVIS

Surveyed 27 AUG 1969, by W. J. RUPPERT