


# T. 2 & 3 S. R. 40 E. W. M.

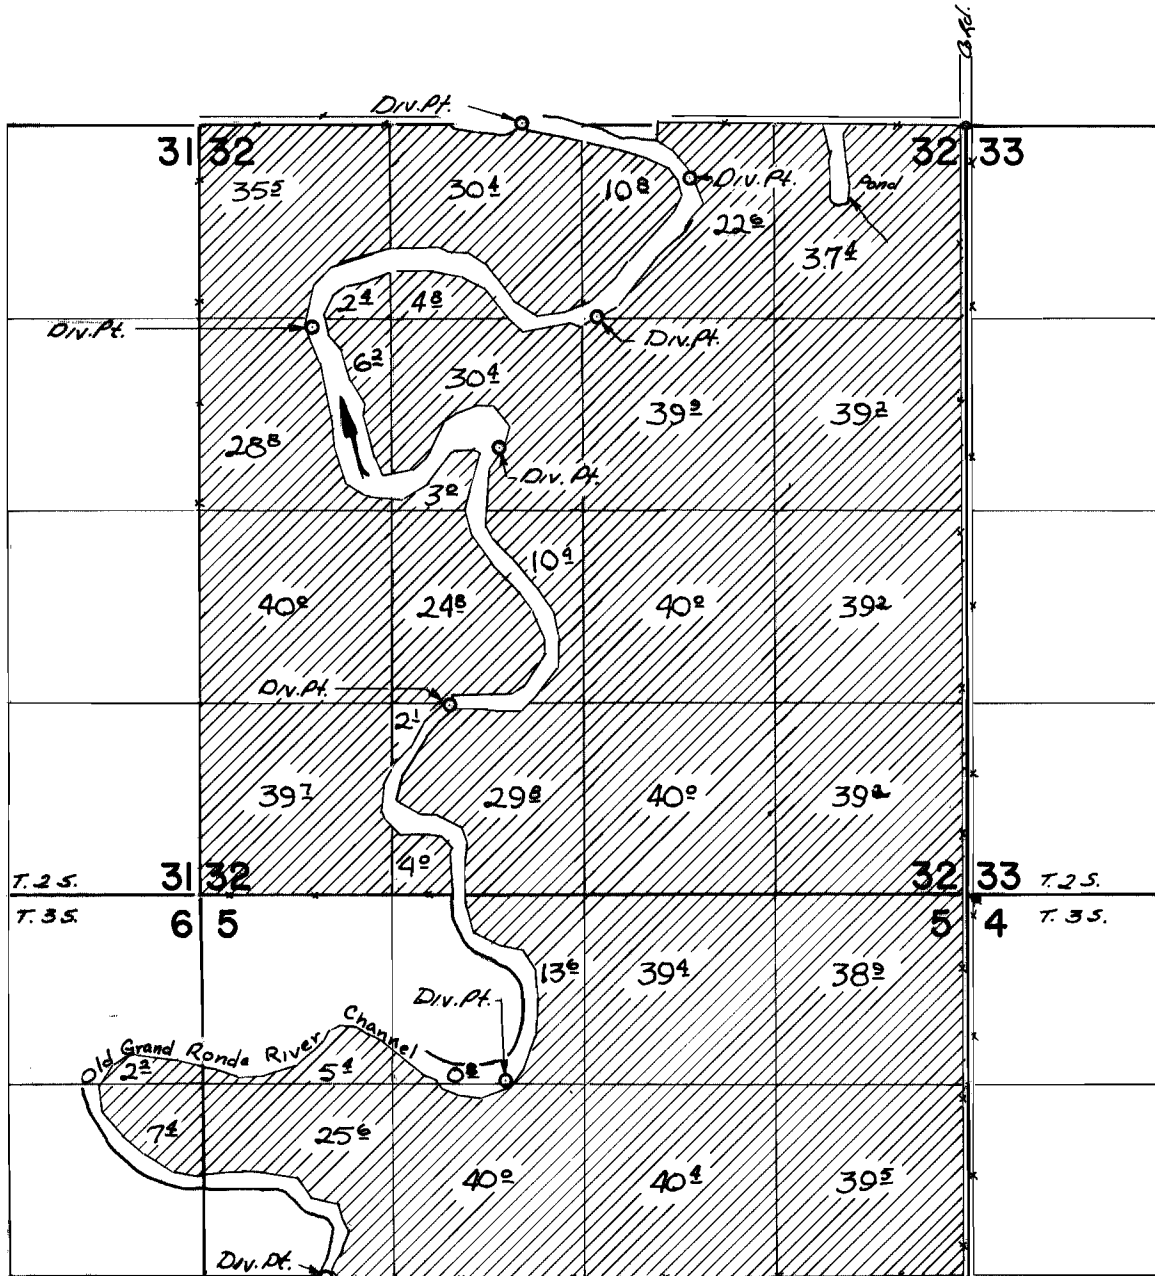

Div. Pts Located: 20' N & 3060' W, 380' S & 1900' W, 1900' S & 2540' W, 1980' S & 4500' W, 2220' S & 3220' W, 3980' S & 3660' W, 6560' S & 3180' W, 7900' S & 4830' W all from NE corner Sec. 82, T. 2 S.

## FINAL PROOF SURVEY UNDER

Application No. 37156 Permit No. 27850  
IN NAME OF

ESTATE OF GRANT CONLEY

Surveyed 20 AUG. 1969, by W. J. RUPPERT