T. 1 S. R. 38 & 39 E. W. M.

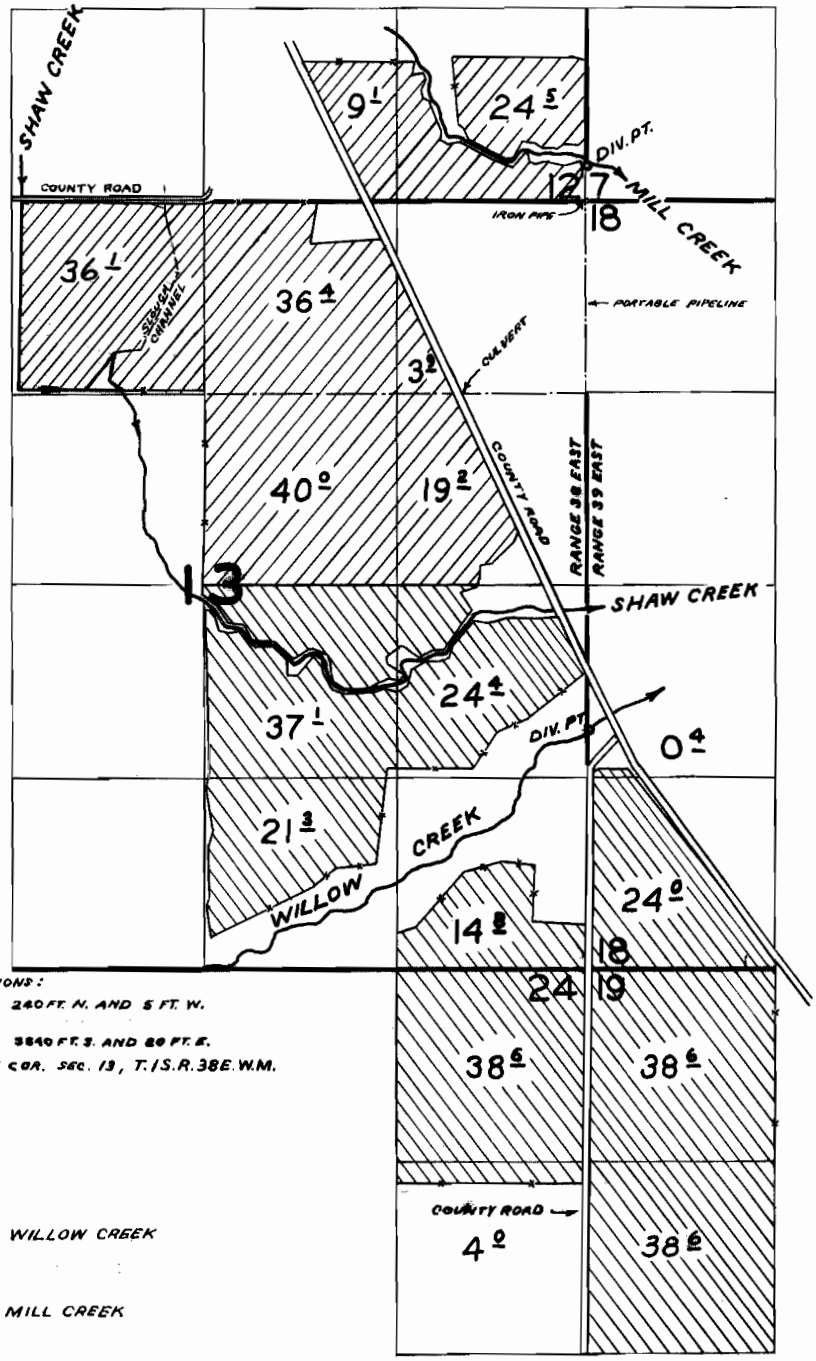

DIVERSION POINT LOCATIONS:
MILL CREEK - 240 FT. N. AND 5 FT. W.
WILLOW CREEK 3840 FT. S. AND 80 FT. E.
ALL BEING FROM THE NE COR. SEC. 13, T. 1 S. R. 38 E. W. M.

WILLOW CREEK

MILL CREEK

FINAL PROOF SURVEY
UNDER

Application No. 37431 37433 Permit No. 27937 27939
IN NAME OF

KEITH GLENN

Surveyed Oct. 28, 1965, by C. Gardner
Inspected July 15, 1969, by W. Ruppert

1965-5 GAB