


T. 1 N. R. 39 & 40 E. W.M.

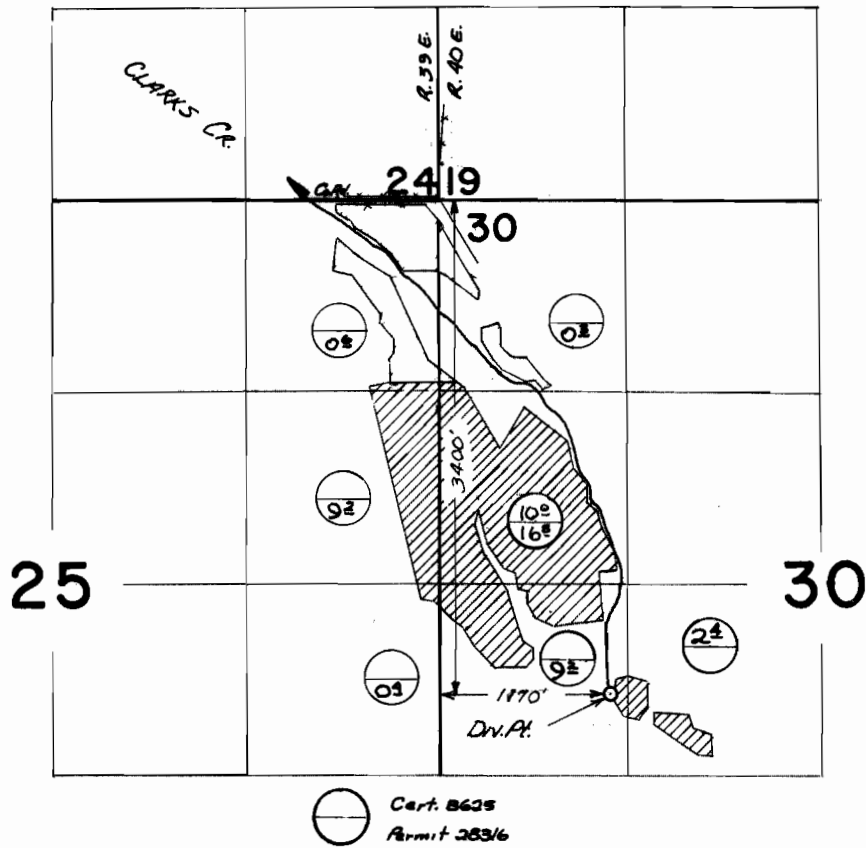

FINAL PROOF SURVEY UNDER

Application No. 37974... Permit No. 28316.....
IN NAME OF

KENNETH W. & JOEL W. BYRNES

Surveyed 26 AUG 1969, by W. J. RUPPERT...