


T.28S.R.12W.W.M.

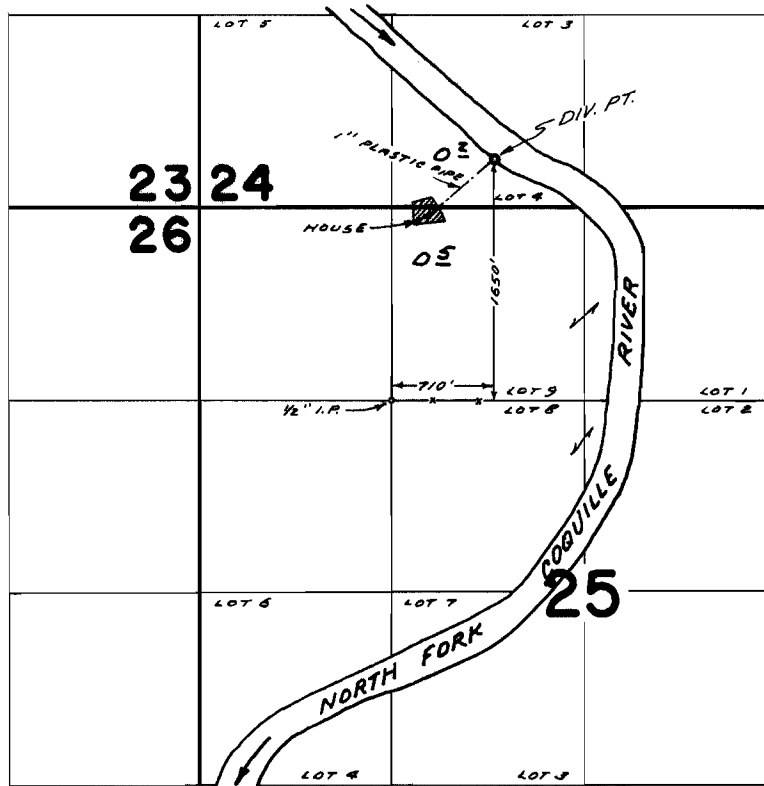

FINAL PROOF SURVEY UNDER

Application No. 39470 Permit No. 29303
IN NAME OF

RON CRIBBINS

Surveyed AUG 26 1969, by D. BUELL