


# T. 14S. R. 16E. W.M.

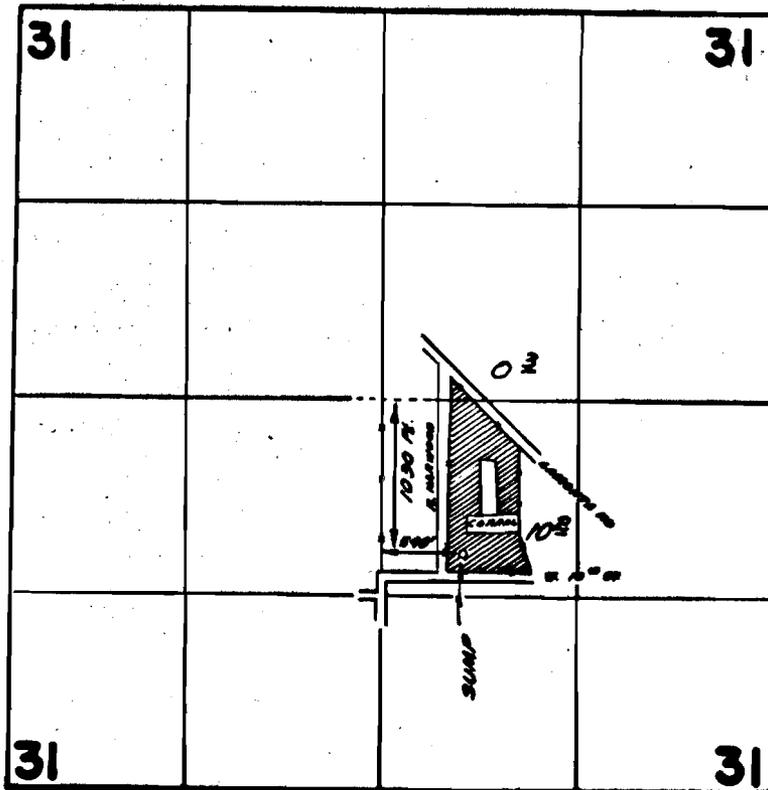

## FINAL PROOF SURVEY UNDER

Application No. ~~G-2535~~ Permit No. ~~G-2585~~  
IN NAME OF

*ESTATE OF J. L. CARDIN*

Surveyed ~~date~~ *3* 1968, by *M. d. Ruppert*

*G-2585*