


T.16S. R.18E. W.M.

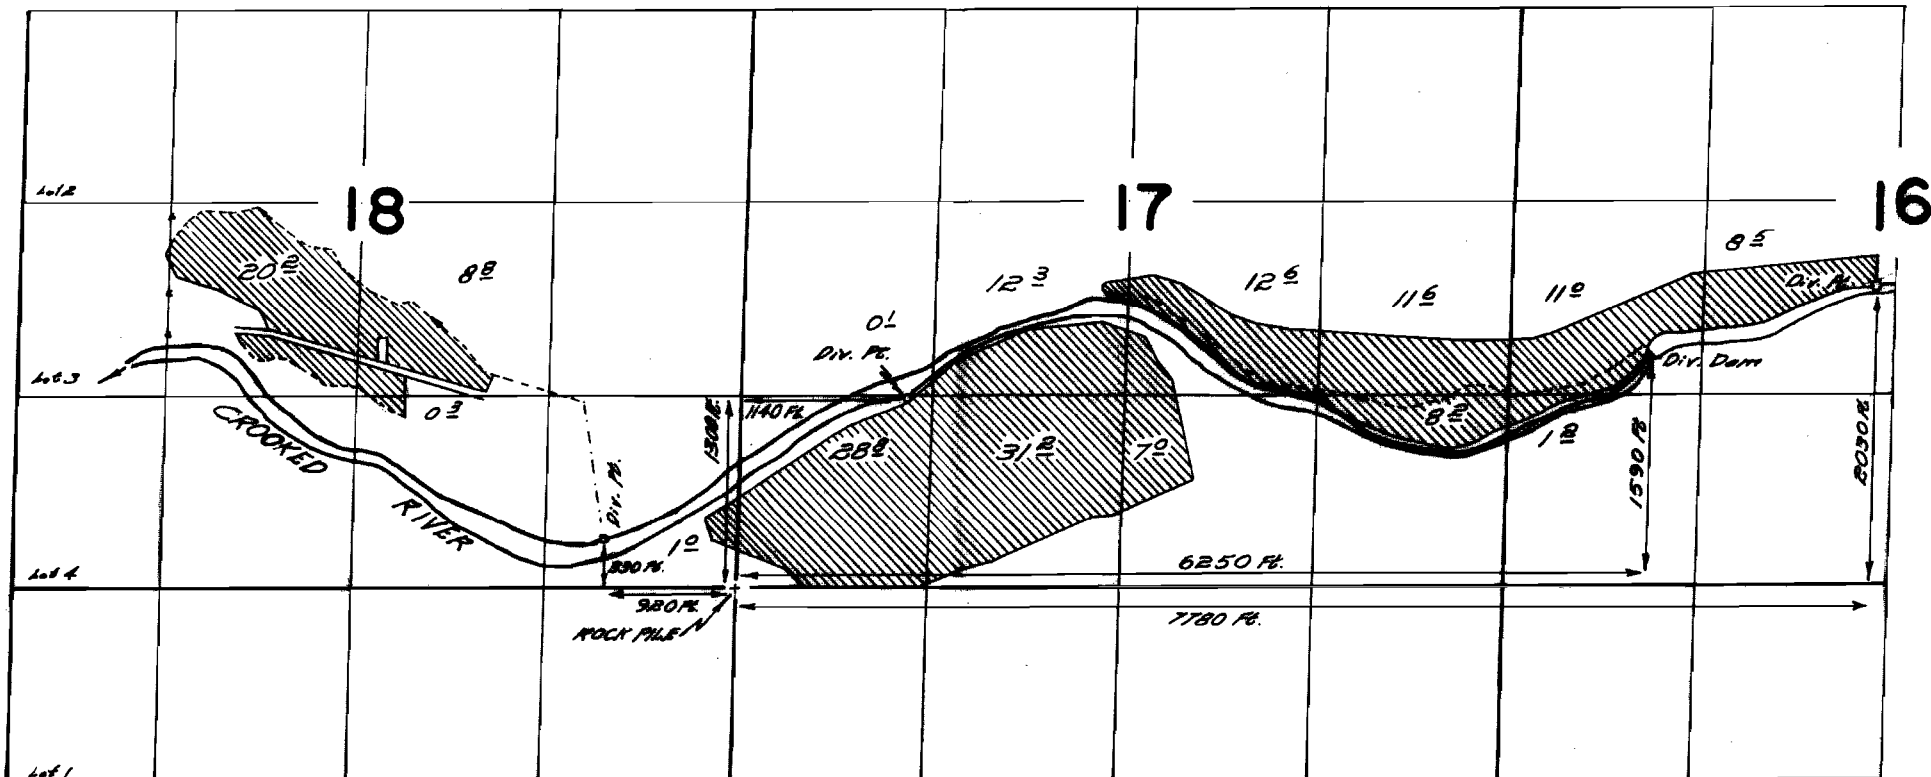

FINAL PROOF SURVEY

UNDER

APPLICATION No. 33135 PERMIT No. 26204

IN NAME OF

ROBERT PORFILY

SURVEYED JUNE 10&11, 1968 BY W.J. RUPPERT