


T.17S. R.20E.W.M.

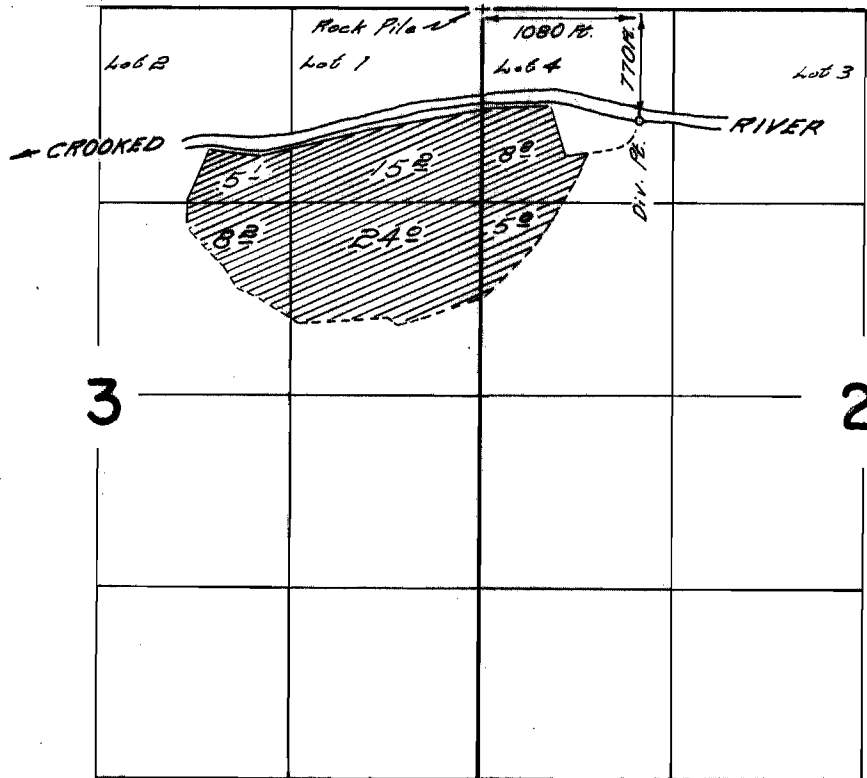

FINAL PROOF SURVEY UNDER

Application No. ~~34544~~ Permit No. 27190
IN NAME OF

MILLER TWEEDT

Surveyed June 8, 1968, by W. J. Fuggart