


5  
C36937  
47488  
T2684

# T.16&17S. R.20E. W.M.

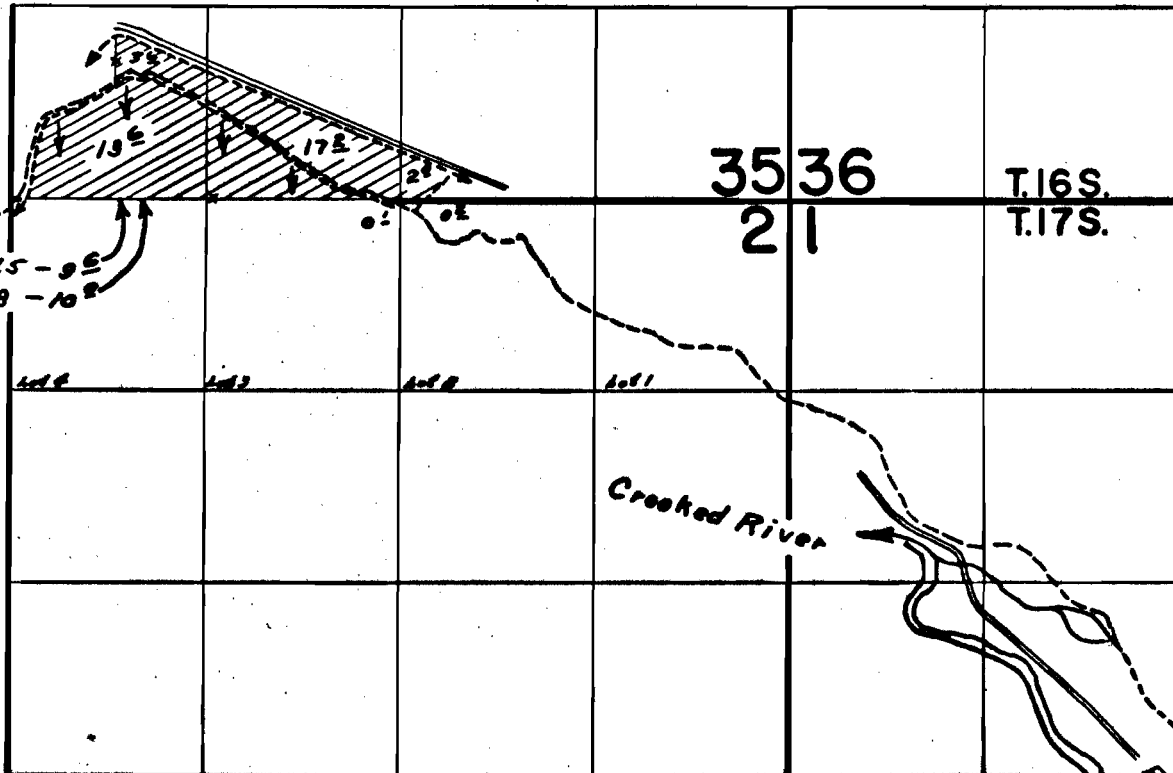

## FINAL PROOF SURVEY UNDER

Application No. 34545... Permit No. 27191...  
IN NAME OF  
**MILLER TWEEDT**

June 8 1968 Wm. J. Ruppert  
Surveyed Oct. 1, 1964, by R. Jackson

Div. Dam  
NW 1/4 NE 74  
SECTION 18

Diversion point  
located 807.5  
± 8780.75 E.  
from N.W. Cor.  
Section 18.

DCY-12H-199 1964-F  
05-05-64

P # 27191