


T.32S.R.15W.W.M.

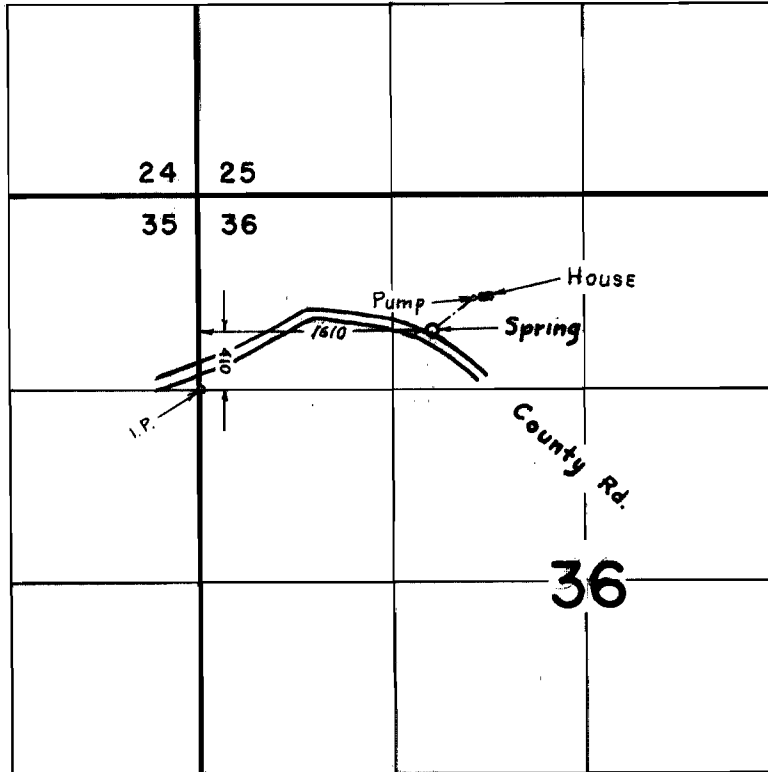

**FINAL PROOF SURVEY**  
UNDER

Application No. 37180 Permit No. 27923  
IN NAME OF

HAROLD P. & MARGARET W. BEERE

Surveyed May 21 1969, by L. E. Gould