


T. 40 S. R. 13 W. W.M.

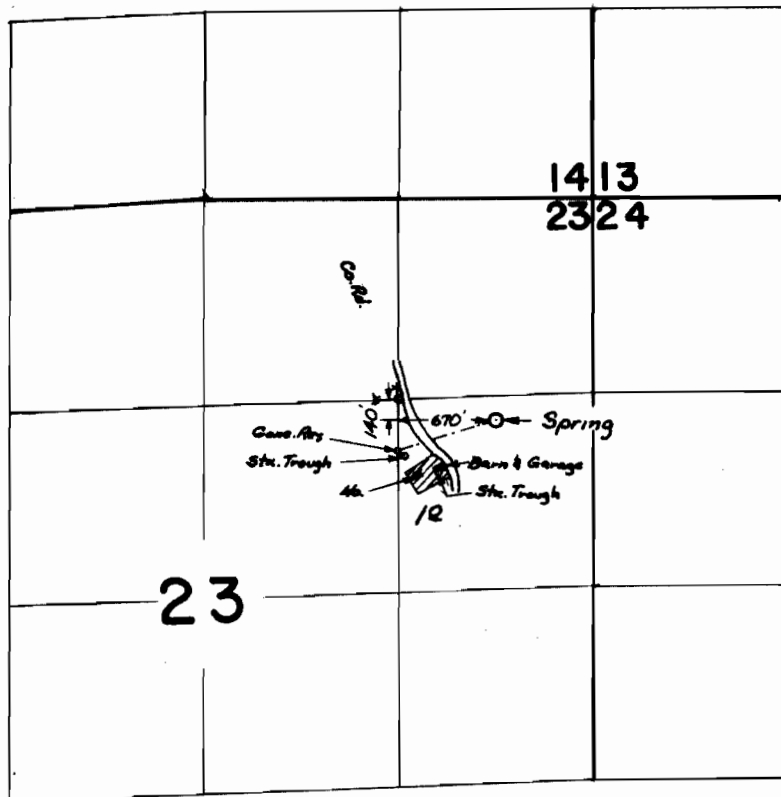

FINAL PROOF SURVEY
UNDER

Application No. 43110 Permit No. 32215
IN NAME OF

MRS. MERWIN (DORENE) CLARK

Surveyed 12 SEPT. 1969, by L.E. GOULD