


T.13S. R.27E.W.M

E. 1/4 Cor SEC. 3
BRASS CAP

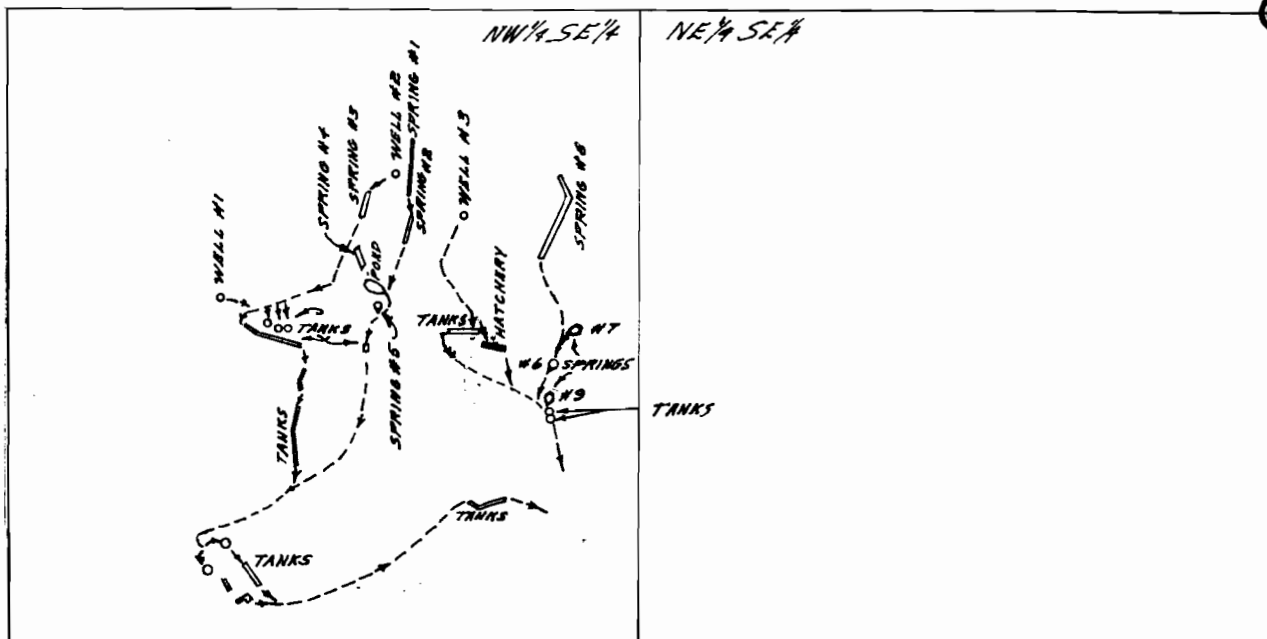

SPRINGS LOCATED: No. 1 - 380' S. & 1810' W.; No. 2 - 460' S. & 1810' W.; No. 3 - 410' S. & 1900' W.; No. 4 - 520' S. & 1910' W.; No. 5 - 620' S. & 1880' W.; No. 6 - 740' S. & 1510' W.; No. 7 - 670' S. & 1460' W.; No. 8 - 430' S. & 1490' W.; No. 9 - 810' S. & 1520' W.; ALL FROM E 1/4 CORNER SECTION 3.

SCALE 1" = 400 FT.

FINAL PROOF SURVEY UNDER

R-33027 R-2295
Application No. ~~53402~~ Permit No. 26447
IN NAME OF

JAMES G. DRISCOLL

Surveyed May 12, 1968, by W.S. Ruppert