


# T.13S.R.27E.W.M.

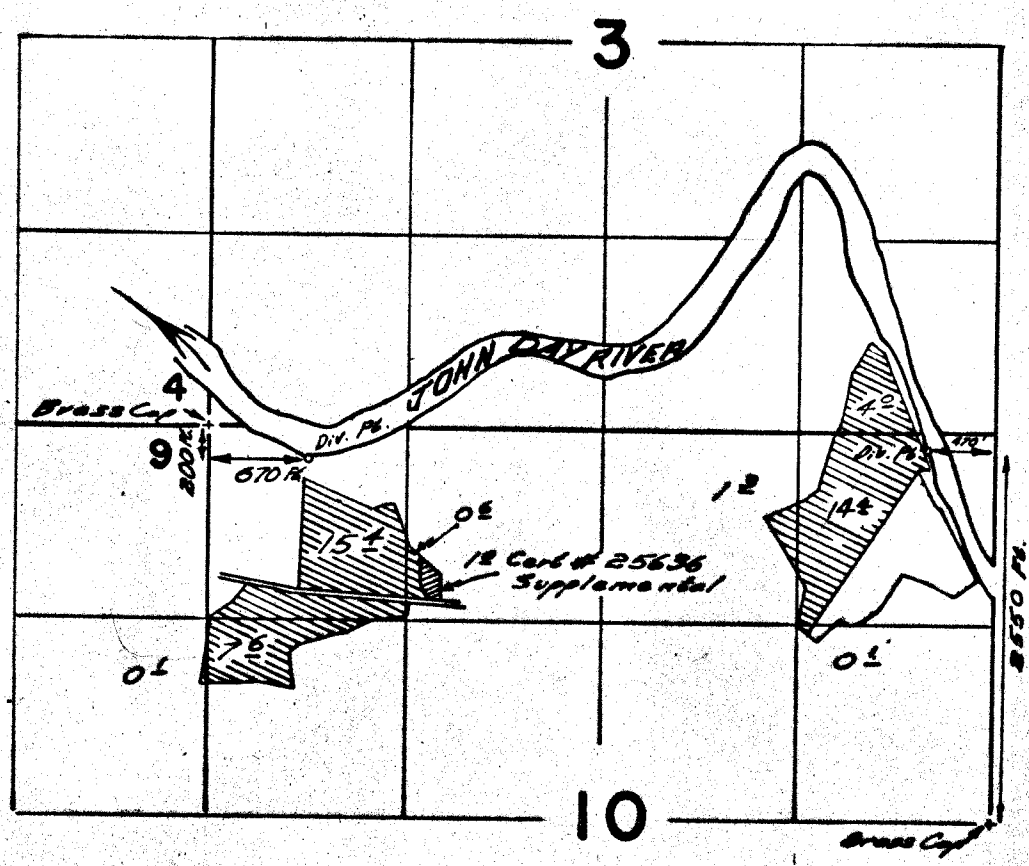

## FINAL PROOF SURVEY UNDER

Application No. ~~38184~~ Permit No. ~~28459~~  
IN NAME OF

**ROY ZEILER**

Surveyed *May 21, 1968*, by *H. J. Ruppert*