


T.24&25S.R.36E.W.M.

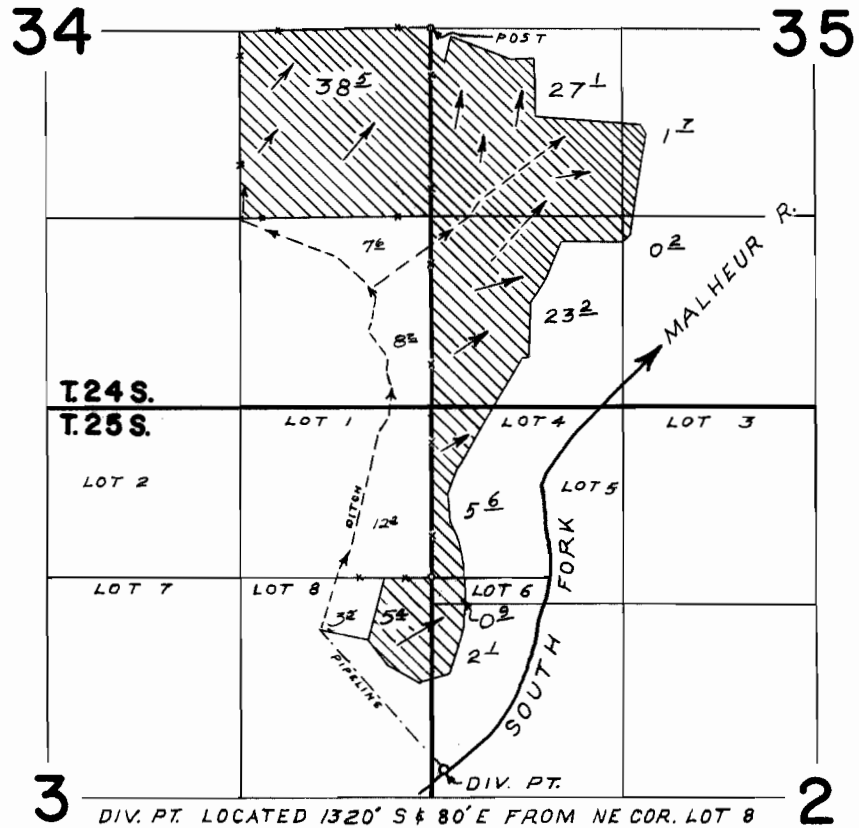

FINAL PROOF SURVEY
UNDER

Application No. 39806 Permit No. 29644
IN NAME OF

T. A. DOMAN

Surveyed SEPT. 13 1968, by W. J. RUPPERT