


T.7S.R.3 & 4W.W.M.

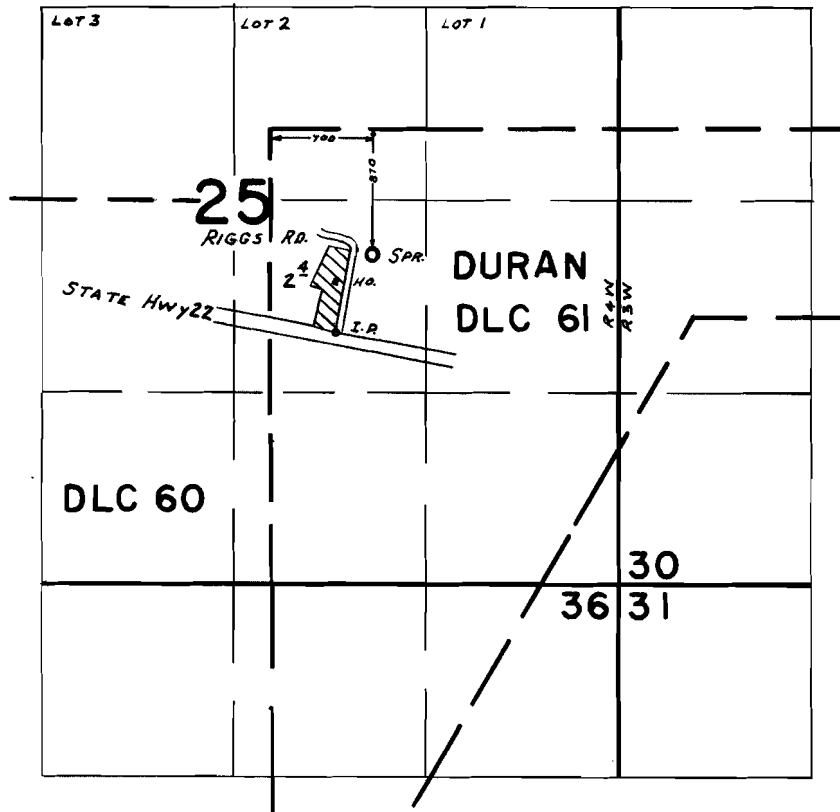

FINAL PROOF SURVEY UNDER

Application No. 40023 Permit No. 29808
IN NAME OF

WILLIAM C. HAWES

Surveyed Nov. 26, 1969, by R. Mucken