


# T.4S. R.11&12 E.W.M.

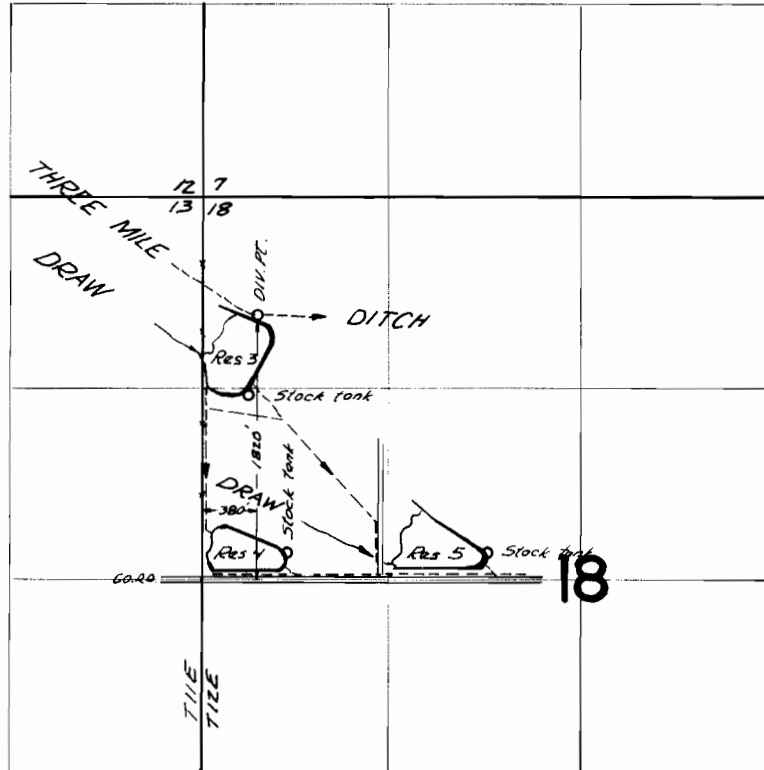

## FINAL PROOF SURVEY UNDER

*R-38521*                      *R-3959*  
*R-38522*                      *R-3960*  
 Application No. *R-38523* Permit No. *R-3961*  
 IN NAME OF

*OREGON STATE GAME COMMISSION*

Surveyed *Nov 11, 1967*, by *V. Garner*