T.4S. R.11&12 E.W.M.

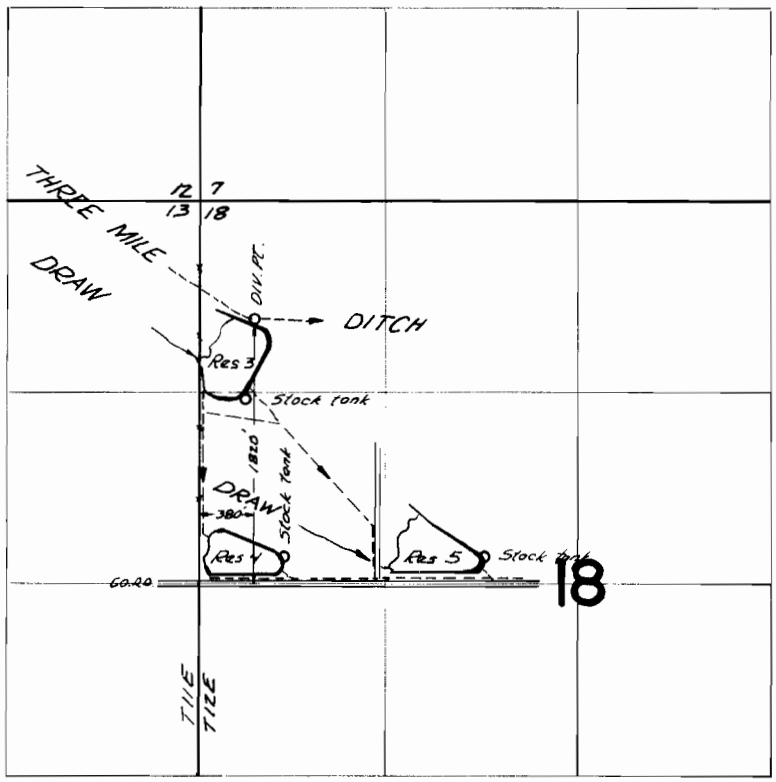

FINAL PROOF SURVEY

UNDER

R-38521 R-3959
R-38522 R-3960
Application No. R-38523 Permit No. R-3961

IN NAME OF

OREGON STATE GAME COMMISSION

Surveyed Nov 11 1967, by V. Garner

1967-F