


T.11S.R.40E.W.M.

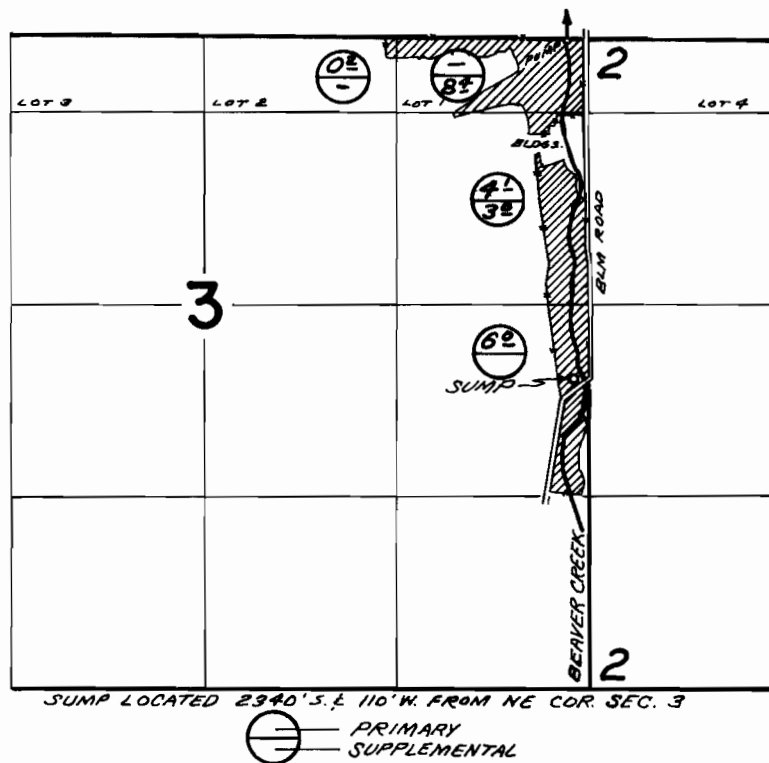

FINAL PROOF SURVEY
UNDER

Application No. 6-3797 Permit No. 6-3583
IN NAME OF

JAMES E. McCUE

Surveyed JUL. 11 1969, by D. BUELL