


# T. 10S. R. 39 & 40 E. W.M.

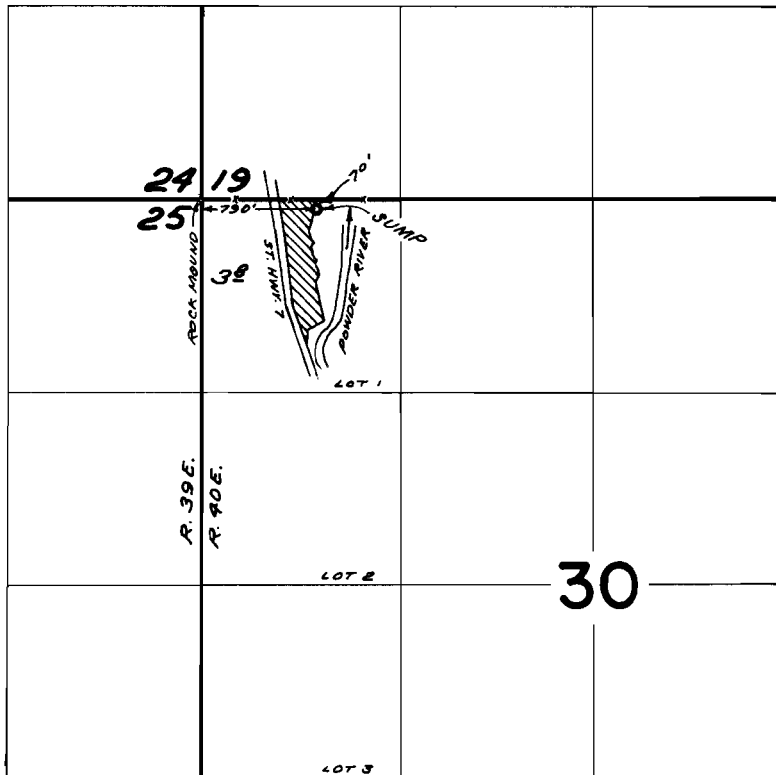

## FINAL PROOF SURVEY UNDER

Application No. G-4584 Permit No. G-4092  
IN NAME OF

JAMES A. ATTAWAY

Surveyed JUL 16 1969, by D. BUELL