
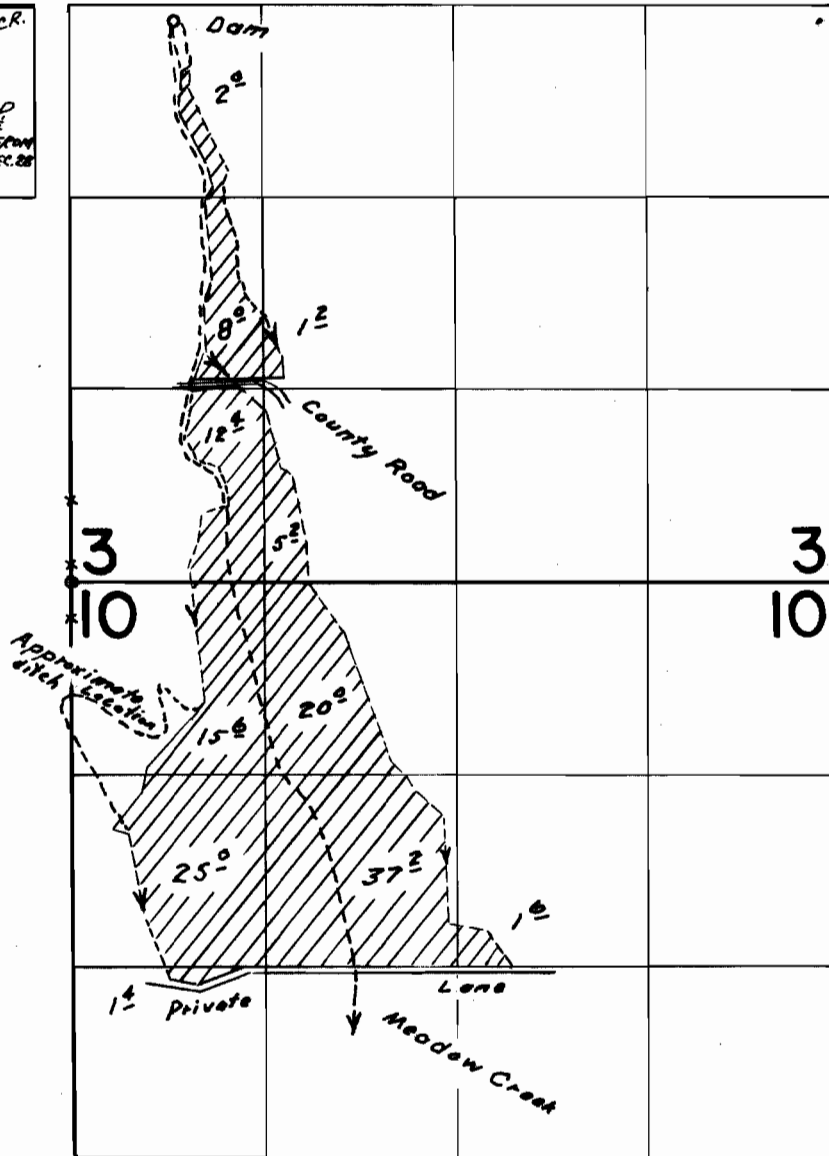


T.12S.R.37E. W.M.

T. 11 S. R. 37 E. W.M.
NW 1/4 NE 1/4 SEC. 28

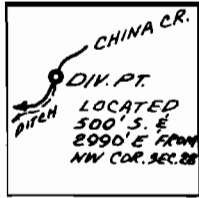

FINAL PROOF SURVEY UNDER

Application No. 33393... Permit No. 26488...
IN NAME OF

VERNELL S. MORIN

Surveyed Nov. 11, 12, 1964, by C. J. Gardner...
JUL. 12, 1969 D. BULL