


# T.10S.R.40E.W.M.

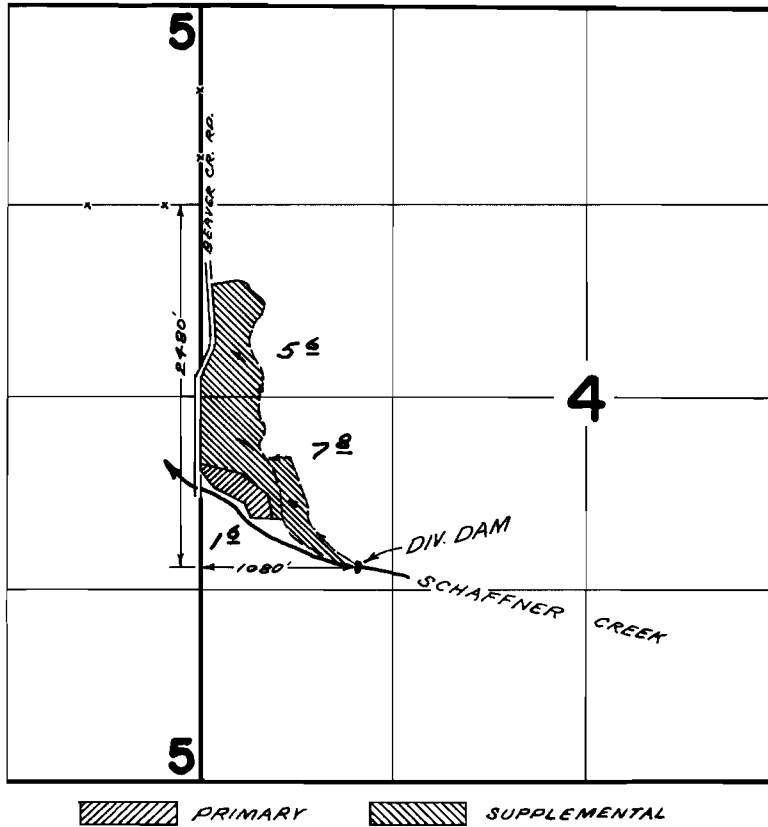

 PRIMARY  SUPPLEMENTAL

## FINAL PROOF SURVEY UNDER

Application No. 40730 Permit No. 30336  
IN NAME OF

KENNETH MARSH

Surveyed JUL. 17 1969, by D. BUELL