


T. 10 S. R. 39 & 40 E. W. M.

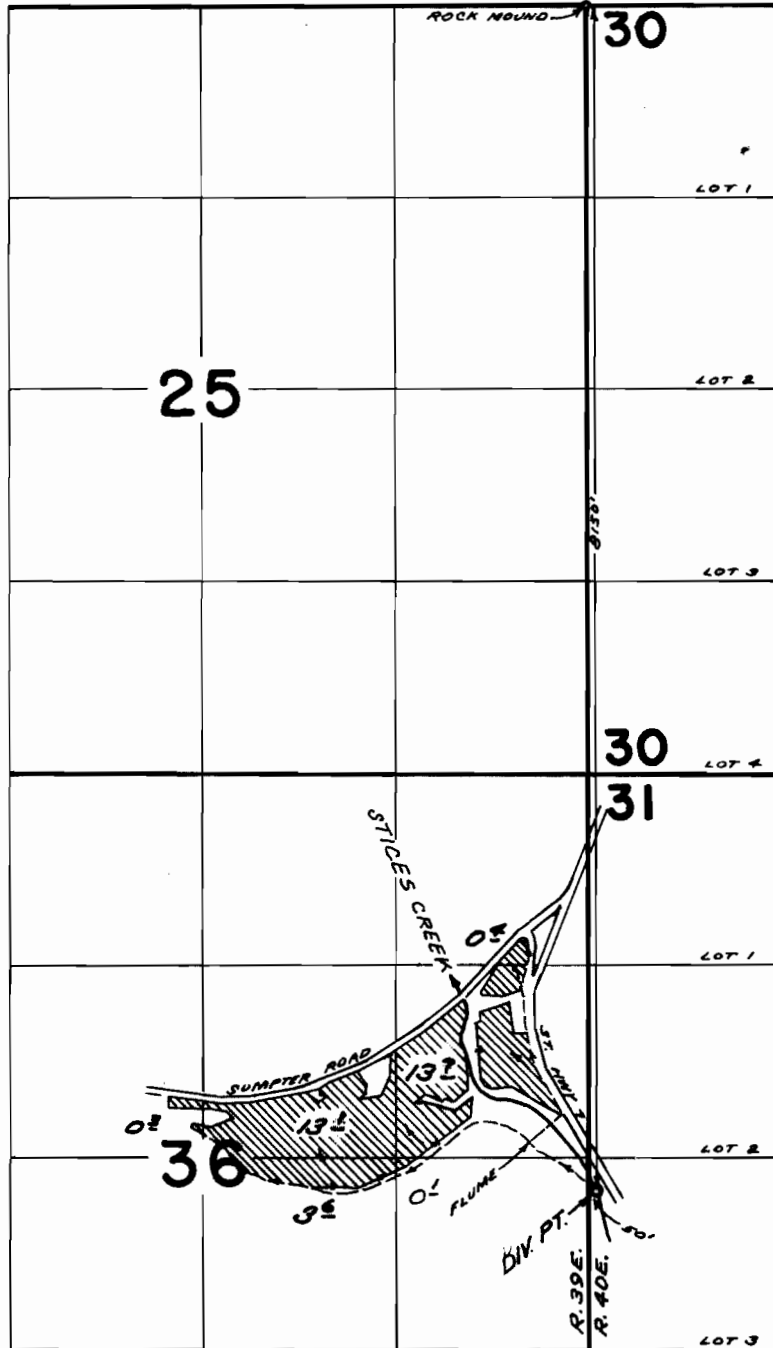

FINAL PROOF SURVEY
UNDER

Application No. 44389 Permit No. 33158
IN NAME OF

U. S. NATIONAL BANK OF OREGON AS TRUSTEE

Surveyed JUL 15 1969, by D. BUELL