


T. 11 & 12 S. R. 5 W. W. M.

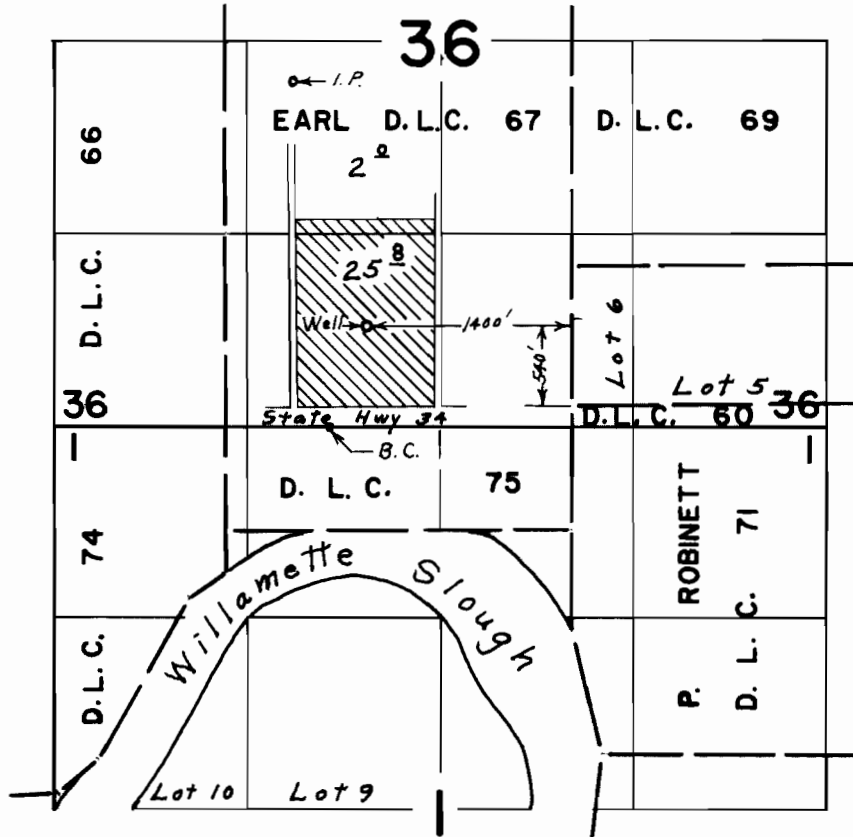

FINAL PROOF SURVEY UNDER

Application No. G-823 Permit No. G-743
IN NAME OF

OREGON STATE COLLEGE

Surveyed Aug. 12, 1969, by L. E. Gould