


T. 12 S. R. 5 & 6 W. W. M.

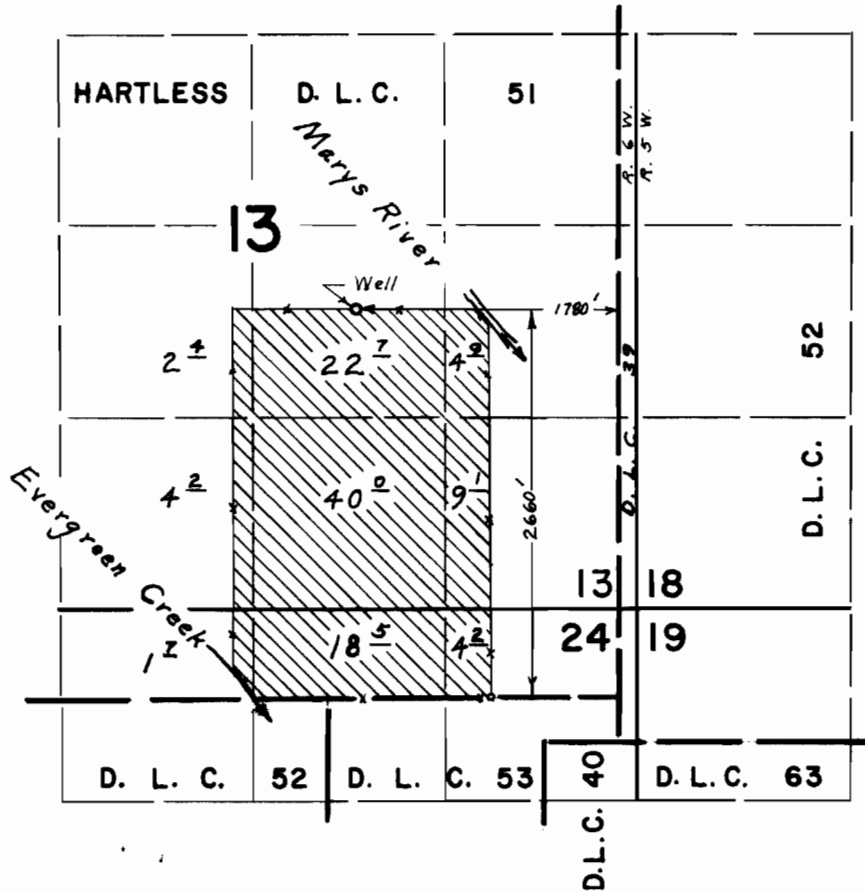

FINAL PROOF SURVEY UNDER

Application No. G-2563 Permit No. G-2373
IN NAME OF

GEORGE SHROYER

Surveyed June 18, 1969, by L. E. Gould