


T. 13 S. R. 4 & 5 W. W. M.

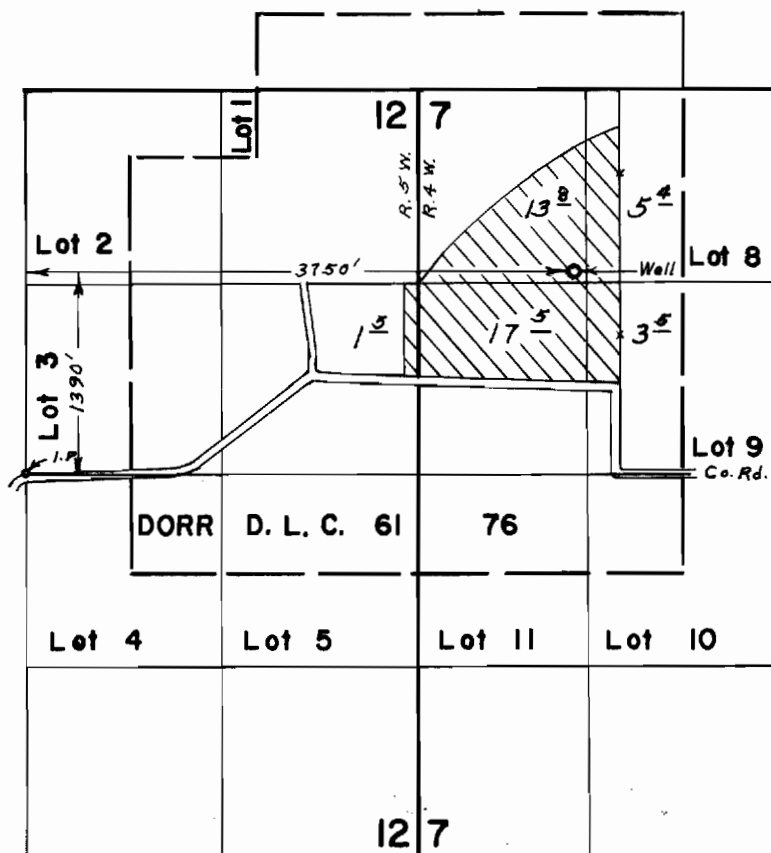

FINAL PROOF SURVEY UNDER

Application No. G-3064 Permit No. G-2873
IN NAME OF

R. DERWOOD SMITH

Surveyed Oct. 30, 1969, by L. E. Gould