


T. 11 S. R. 7 W. W. M.

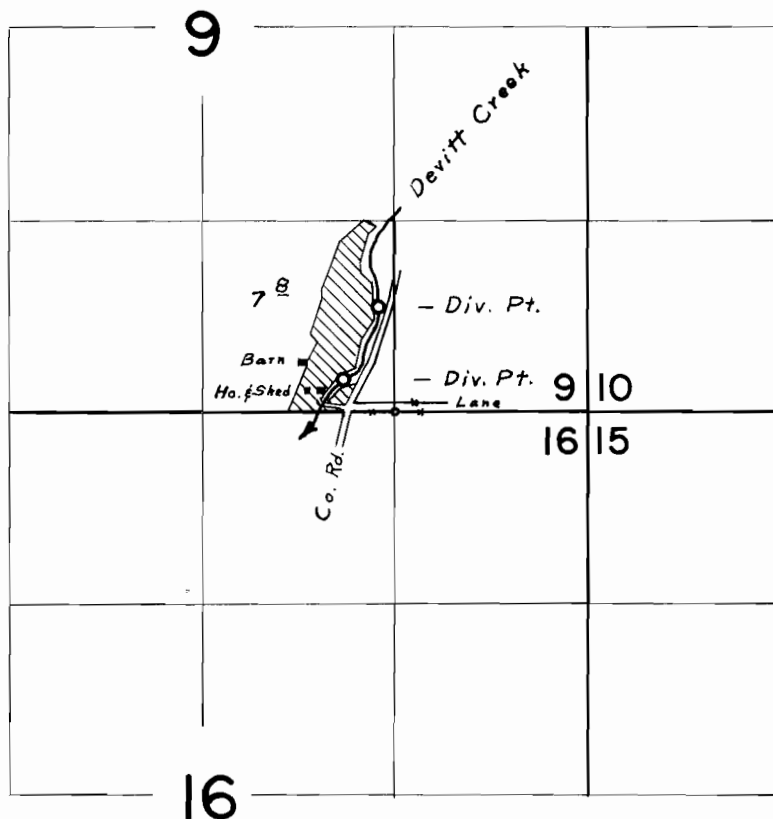

Div. Pts. located; 720' N. & 100' W., 220' N. & 340' W., both from S.E. Cor.
S.W. & S.E. of Sec. 9

FINAL PROOF SURVEY
UNDER

Application No. 37394 Permit No. 27835
IN NAME OF

B. E. LOVERIN

Surveyed Sept. 4, 1969, by L. E. Gould