


T. 13 S. R. 5 W. W.M.

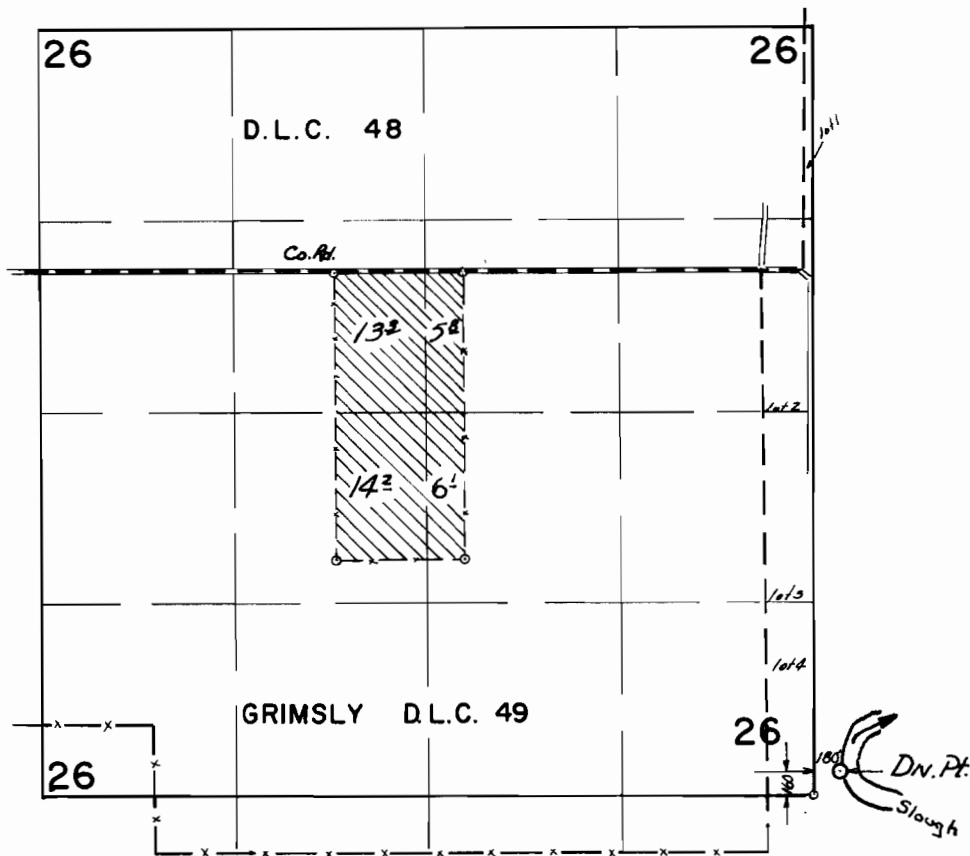

FINAL PROOF SURVEY
UNDER

Application No. 42276 Permit No. 31619
IN NAME OF

C. E. MILLER

Surveyed 30 OCT. 1969, by L. E. GOULD