


T.29S.R.14W.W.M.

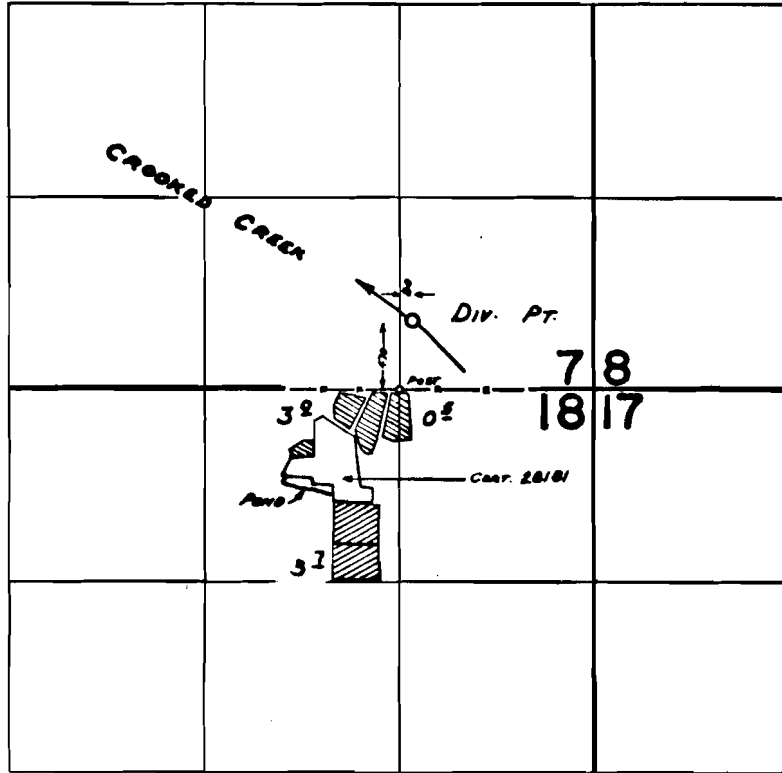

 PERMIT 29868  
 " 26559

**FINAL PROOF SURVEY**  
UNDER

33569                      26559  
Application No. 40077      Permit No. 29868  
IN NAME OF  
**JAY HESS**

Surveyed *MAY 15, 1969*, by *W. RUPPERT*