


# T.29S.R.14W.W.M.

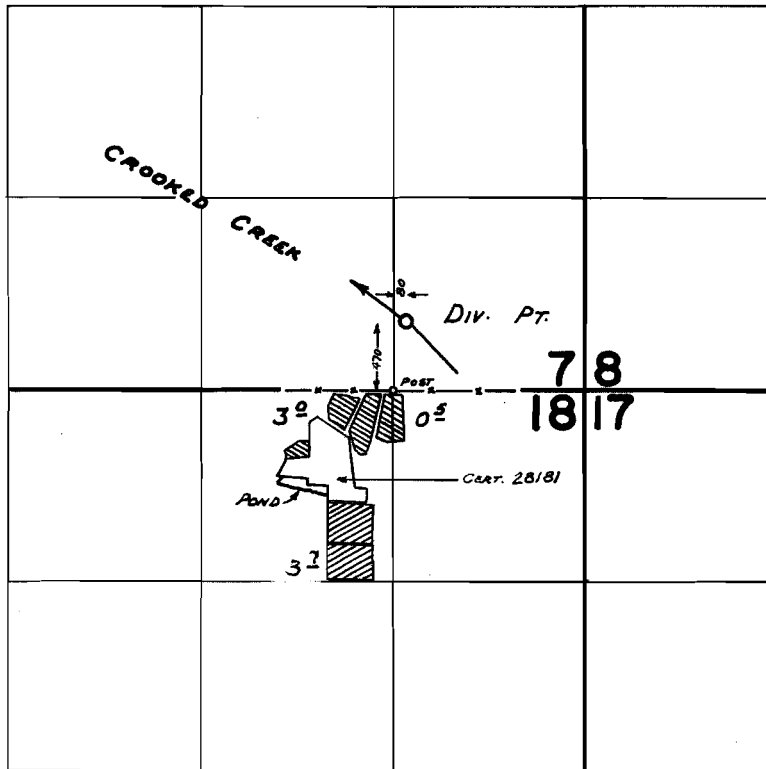

## FINAL PROOF SURVEY UNDER

33569                      26559  
 Application No. 40077      Permit No. 29868  
 IN NAME OF

JAY HESS

Surveyed May 15, 1969, by W. RUPPERT