


# T.30S.R.14 & 15W.W.M.

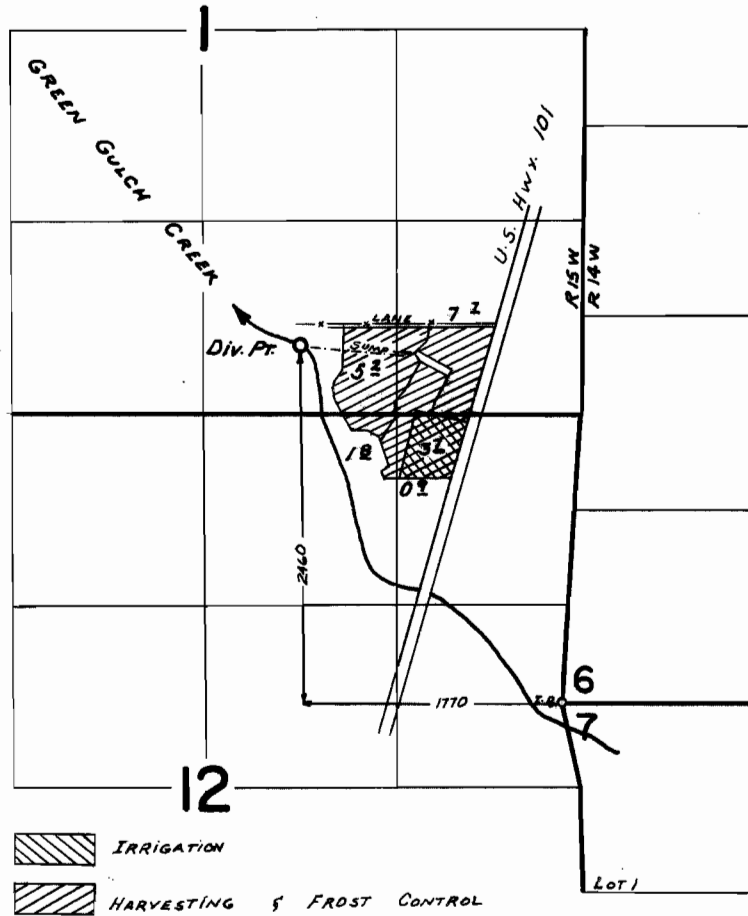

## FINAL PROOF SURVEY UNDER

Application No. 41670 Permit No. 31096  
IN NAME OF

PANTER RANCH by CHARLES W. PANTER

Surveyed MAY 20 1969, by W. RUPPERT