


T.28S.R.14W.W.M.

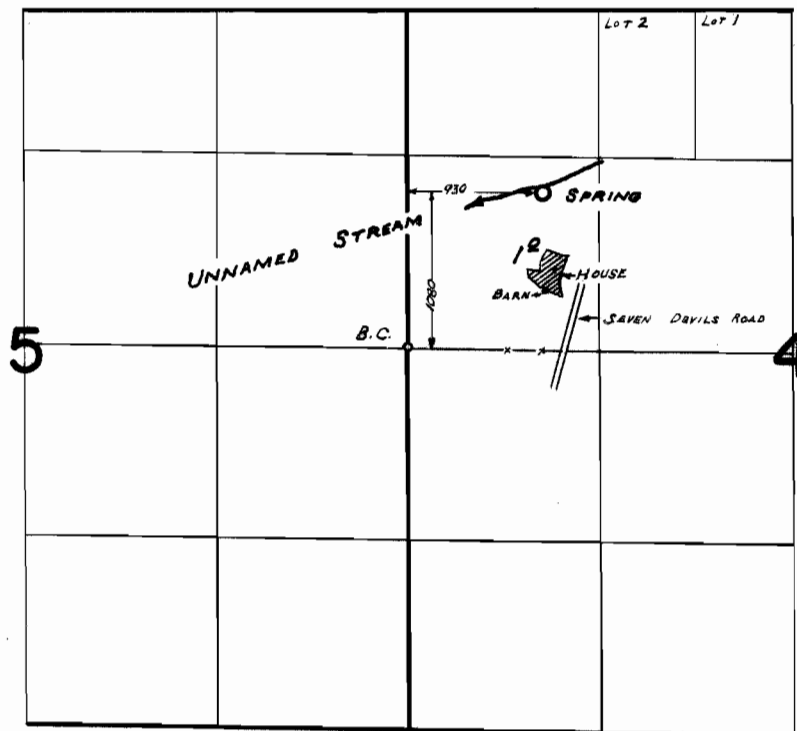

FINAL PROOF SURVEY
UNDER

Application No. 38123 Permit No. 28412
IN NAME OF

FRANK JARVIS

Surveyed MAY 13 1969, by W. RUPPERT