


T.27S.R.14W.W.M.

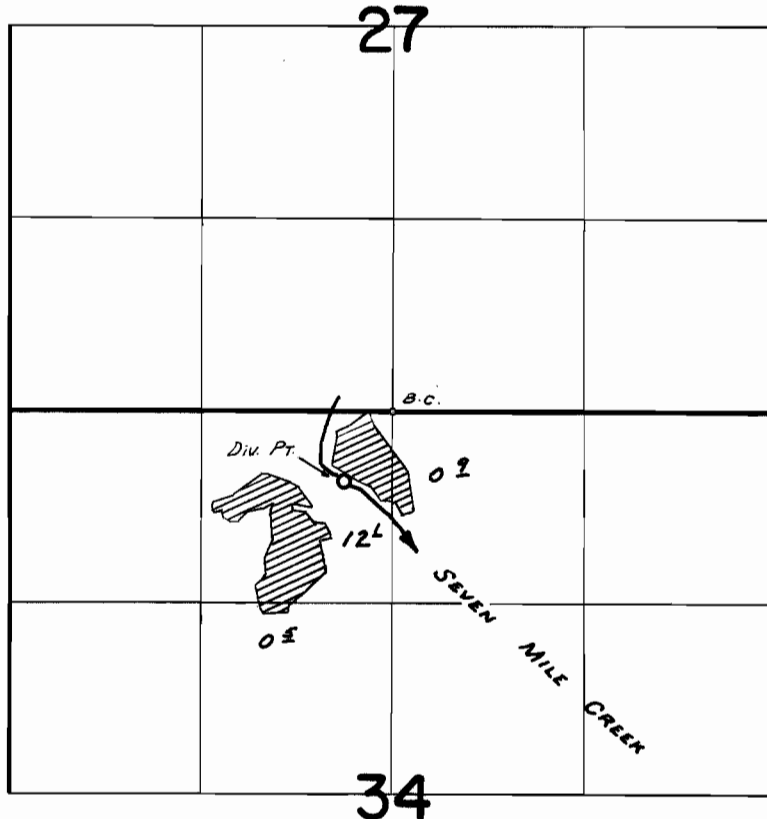

Div. Pt. LOCATED: 480' S & 330' W FROM N 1/4 COR. SEC. 34

FINAL PROOF SURVEY
UNDER

Application No. 37921..... Permit No. 20292.....
IN NAME OF

STEWART R. CAMERON

Surveyed May 13 1969, by W. RUPPERT