


T.29S.R.14W.W.M.

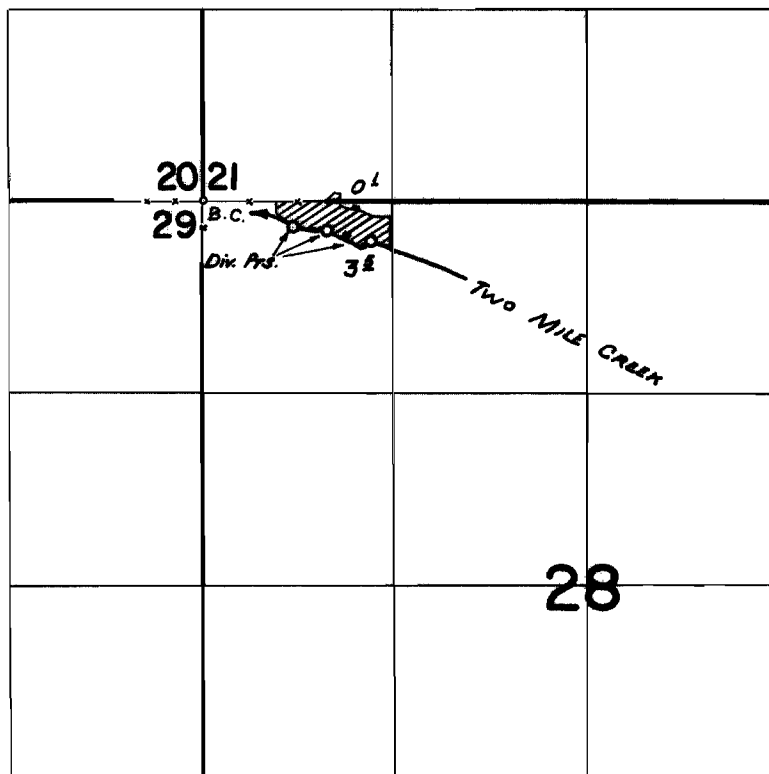

DIV. PTS. LOCATED: 180'S & 620'E ALL FROM N.W. COR. SEC. 28
200'S & 860'E
270'S & 1160'E

FINAL PROOF SURVEY
UNDER

Application No. 38461 Permit No. 28805
IN NAME OF

NEWTON L. DICKEY

Surveyed MAY 12 1969, by W. RUPPERT