T.30S.R.15W.W.M.

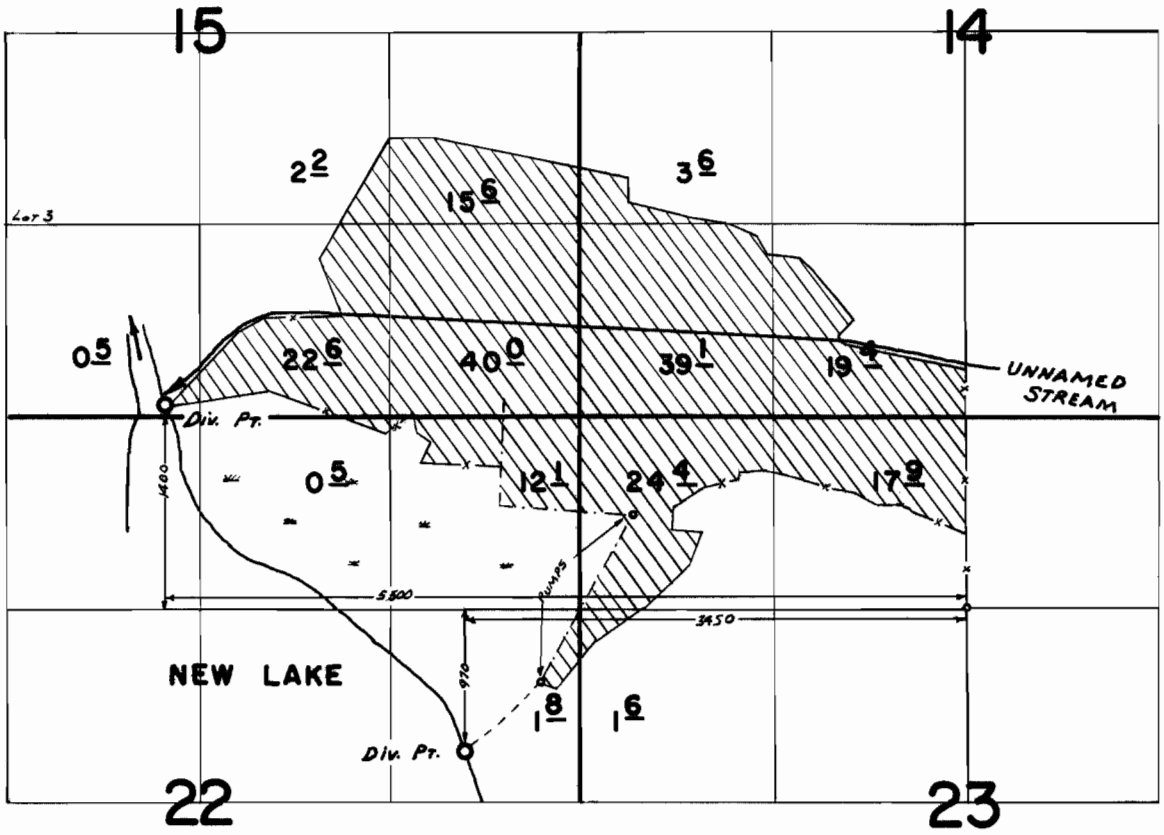

FINAL PROOF SURVEY
UNDER

Application No. 39809 Permit No. 29498
IN NAME OF

RODERICK T. McKENZIE

Surveyed May 21 1969, by W. Ruppert

B.M.
1969-K