


Bish's note
 says House
 approx 200 ft from
 Div. Pt. one intened
 by permit. I concur.
 1-31-89
 See App. Map.

T.28S.R.14W.W.M.

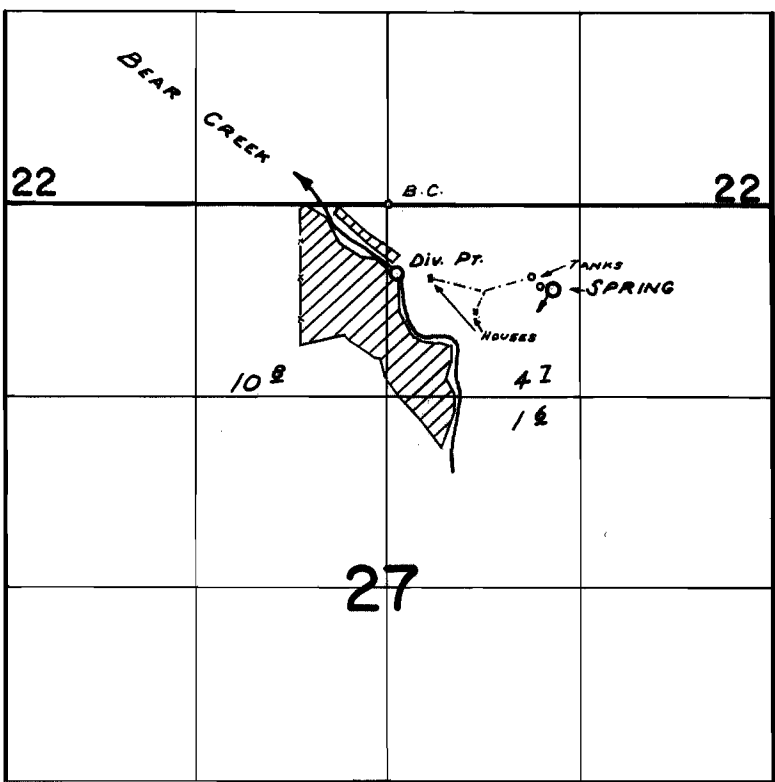

Div. Pts. LOCATED: 60' E. & 470' S. BOTH FROM N. 1/4 COR. SEC. 27
 1140' E. & 580' S.

FINAL PROOF SURVEY
 UNDER

Application No. 39687 Permit No. 29536
 IN NAME OF

ORVAL L. LONGANECKER

Surveyed MAY 15, 1969, by W. RUPPERT