


T.30S.R.14W.W.M.

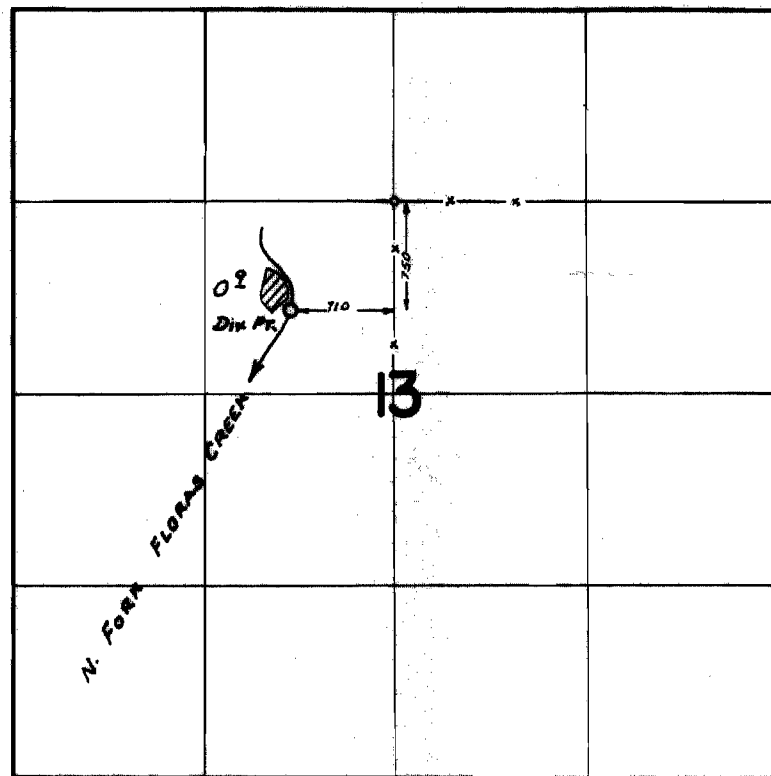

FINAL PROOF SURVEY
UNDER

Application No. 39748 Permit No. 29633
IN NAME OF

R. E. McLEOD

Surveyed MAY 22, 1969, by W. RUPPERT