


T.29S.R.15W.W.M.

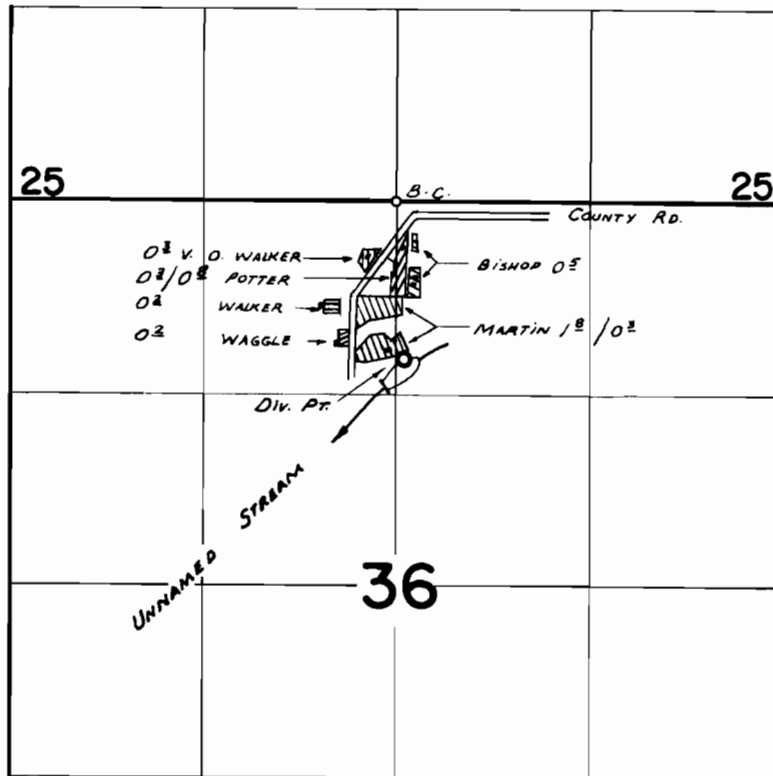

Div. Pt. LOCATED: 60' E & 1080' S. FROM N 1/4 COR Sec. 36

FINAL PROOF SURVEY UNDER

Application No. 37430 Permit No. 29965
IN NAME OF

MILDRED C. MARTIN

Surveyed MAY 20, 1969, by W. SUPPERT