


T.30S.R.15W.W.M.

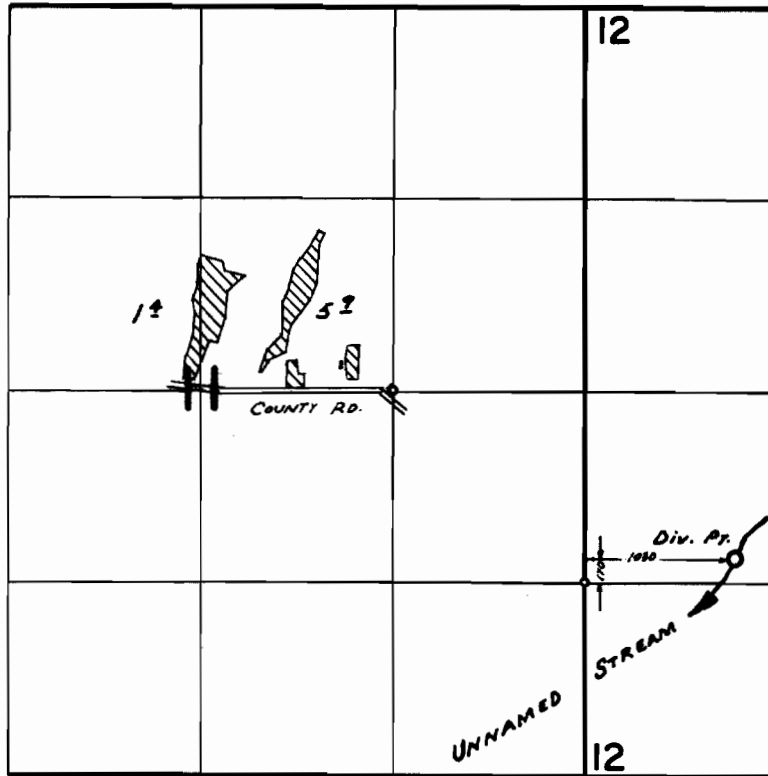

FINAL PROOF SURVEY
UNDER

Application No. 43469 Permit No. 325/3
IN NAME OF

ERNEST A. STORM

Surveyed MAY 23 1969, by W. RUPPERT