


T.17S. R.20E. W.M.

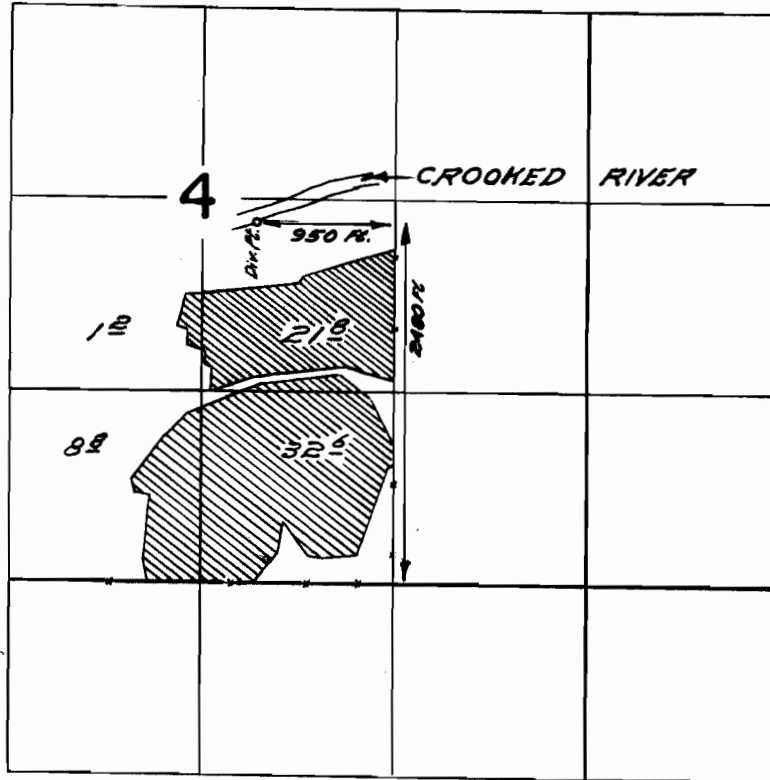

FINAL PROOF SURVEY UNDER

Application No. 34950 Permit No. 27410
IN NAME OF

CLYDE WAYLAND

Surveyed June 8 1968, by W. J. Kuppert