


C 36981

T.15S. R.20E.W.M.

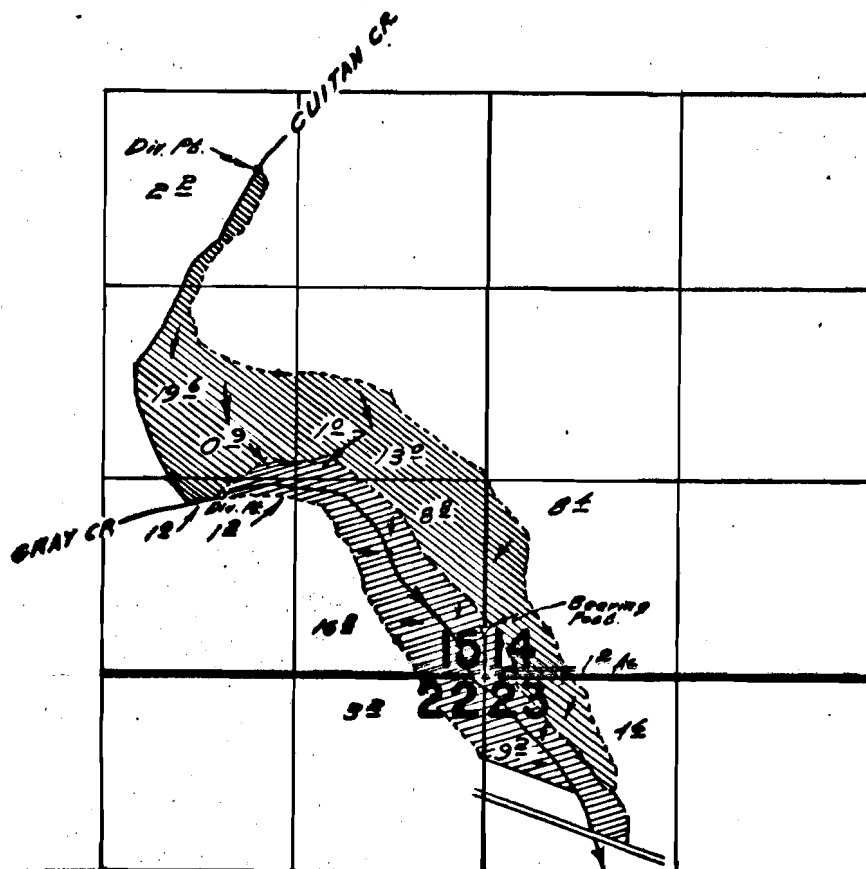

DIVERSION POINT FROM CUITAN CR. 3450 FE. N & 1580 FE. W
 DIVERSION POINT FROM GRAY CR. 1800 FE. N & 1800 FE. W
 BOTH FROM SE. CORNER SECTION 15

FINAL PROOF SURVEY UNDER

Application No. 35026 27537
 Permit No. 35027 27536
 IN NAME OF

U.S. DEPARTMENT OF AGRICULTURE

Surveyed June 7, 1968, by A.D. Ruppert

P* 27536 T 7