


T. 41 S. R. 13 W. W. M.

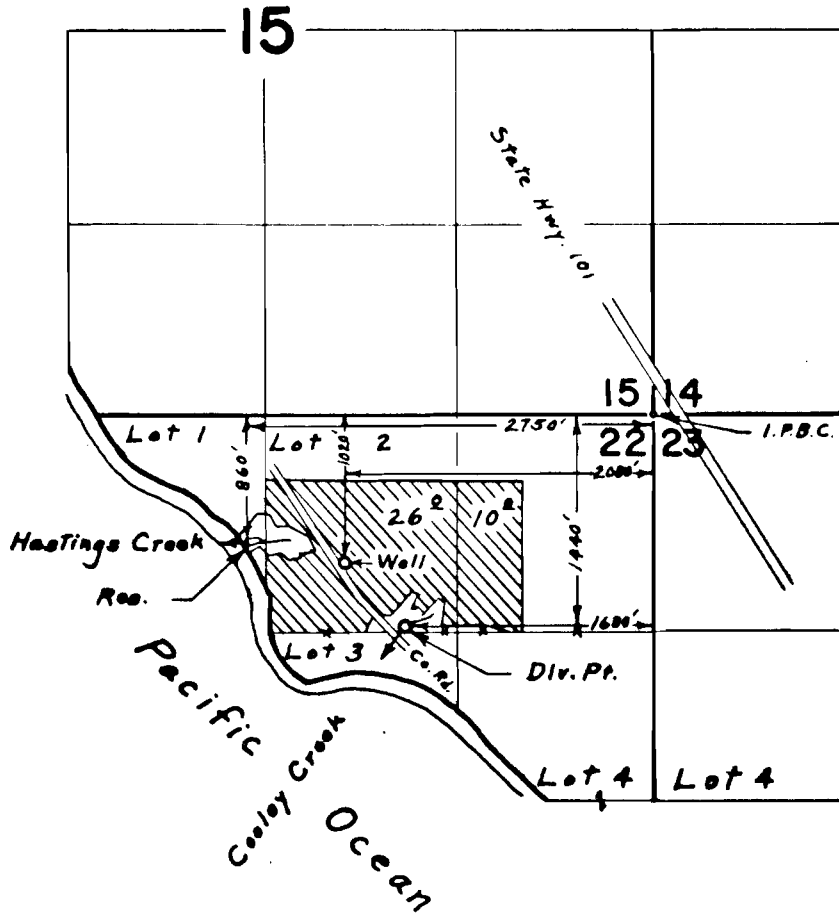

FINAL PROOF SURVEY
UNDER

R-44201 R-5021
43700 32659
Application No. G-4120 Permit No. G-3717
IN NAME OF

ROBERT K. & ELIZABETH C. HASTINGS

Surveyed Sept. 12, 1969, by L. E. Gould