


# T. 41 S. R. 13 W. W. M.

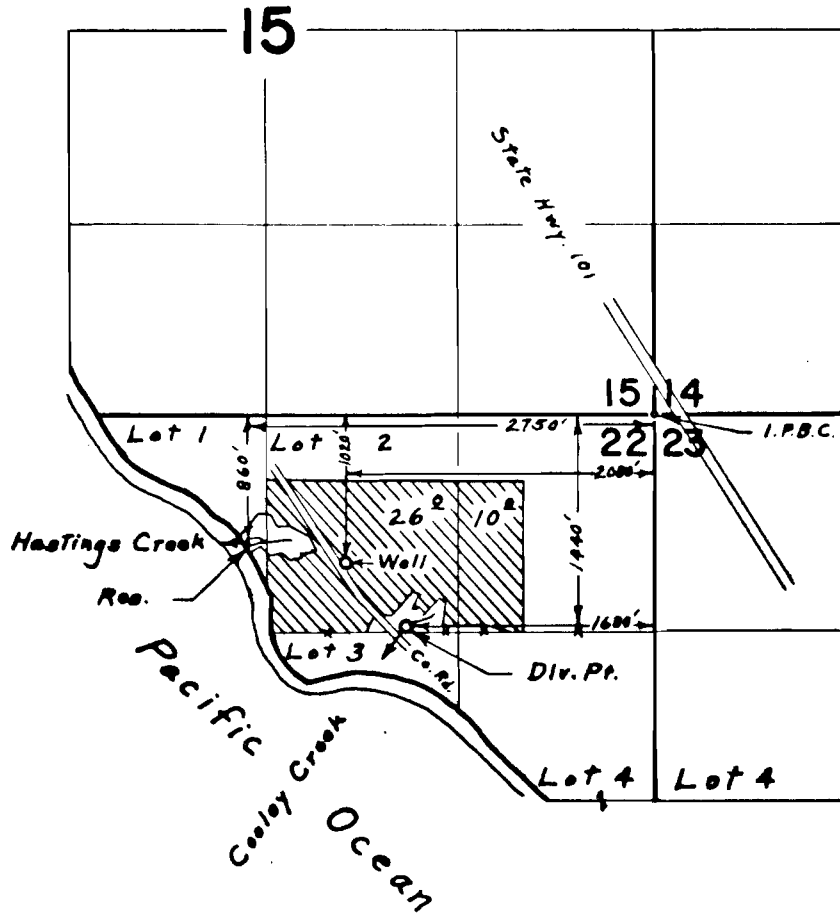

## FINAL PROOF SURVEY UNDER

R-44201                      R-5021  
 43700                         32659  
 Application No. G-4120    Permit No. G-3717  
 IN NAME OF

**ROBERT K. & ELIZABETH C. HASTINGS**

Surveyed Sept. 12, 1969, by L. E. Gould