


T. 41 S. R. 13 W. W.M.

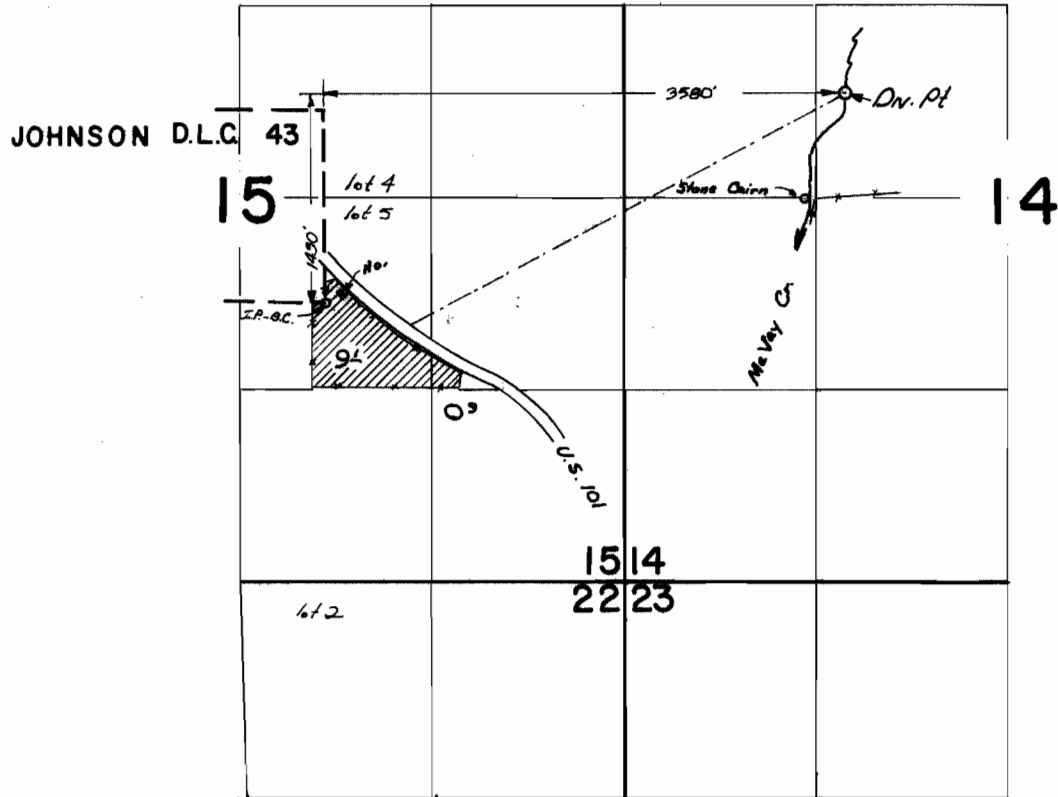

FINAL PROOF SURVEY
UNDER

Application No. 39774 Permit No. 29640
IN NAME OF

CLIFFORD WILSON

Surveyed 13 SEPT. 1969, by L. E. GOULD