


T. 29 S. R. 8 W. W. M.

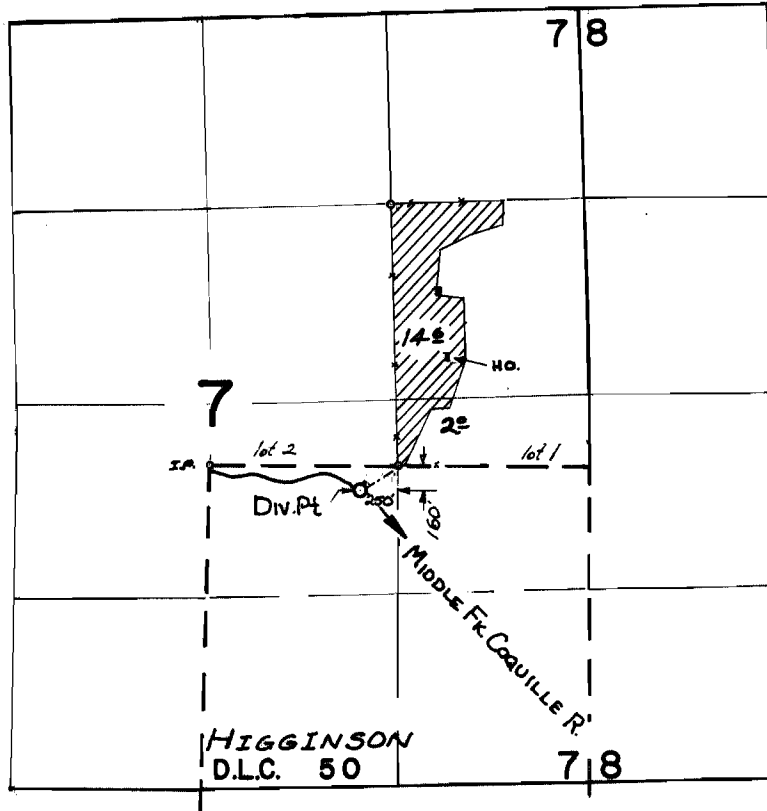

FINAL PROOF SURVEY
UNDER

Application No. 38117 Permit No. 28409
IN NAME OF

RICHARD JACK WARREN

Surveyed 10 SEPT. 1969, by W. J. RUPPERT