


T. 29 S. R. 8 W.W.M.

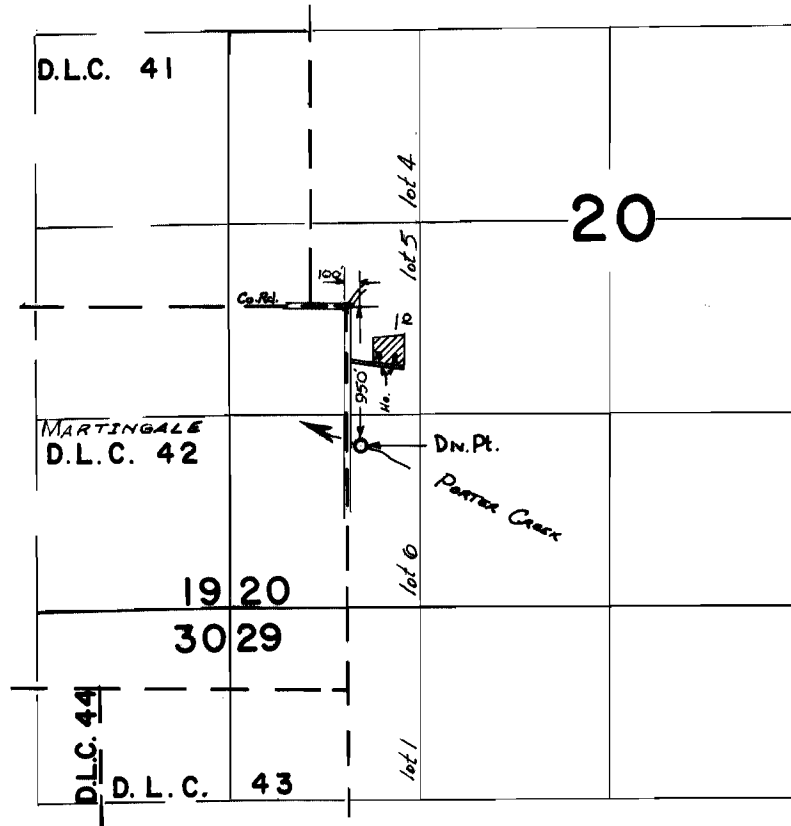

FINAL PROOF SURVEY
UNDER

Application No. 37814 Permit No. 28424
IN NAME OF

LESLIE EMERY CATCHPOLE

Surveyed 10 SEPT 1969, by W. J. RUPPERT