


T. 22 S. R. 4 W. W.M.

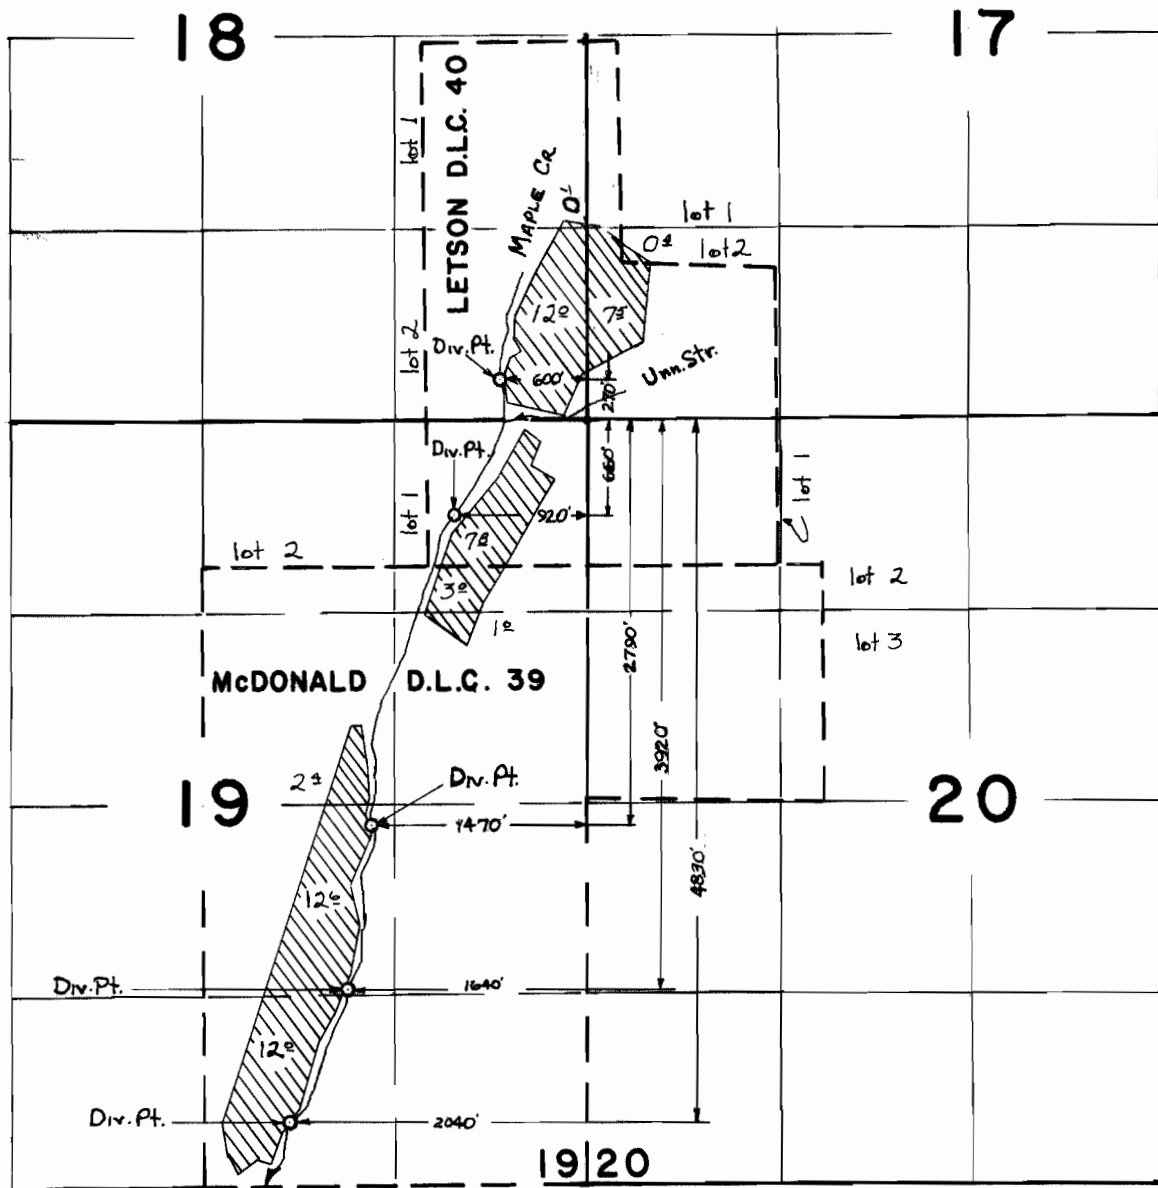

FINAL PROOF SURVEY
UNDER

Application No. 38720 Permit No. 28832
IN NAME OF

SHERRY & LESLIE E. CLAXTON

Surveyed 10 JULY 1969, by W.J. RUPPERT