


T. 29 S. R. 8 W. W.M.

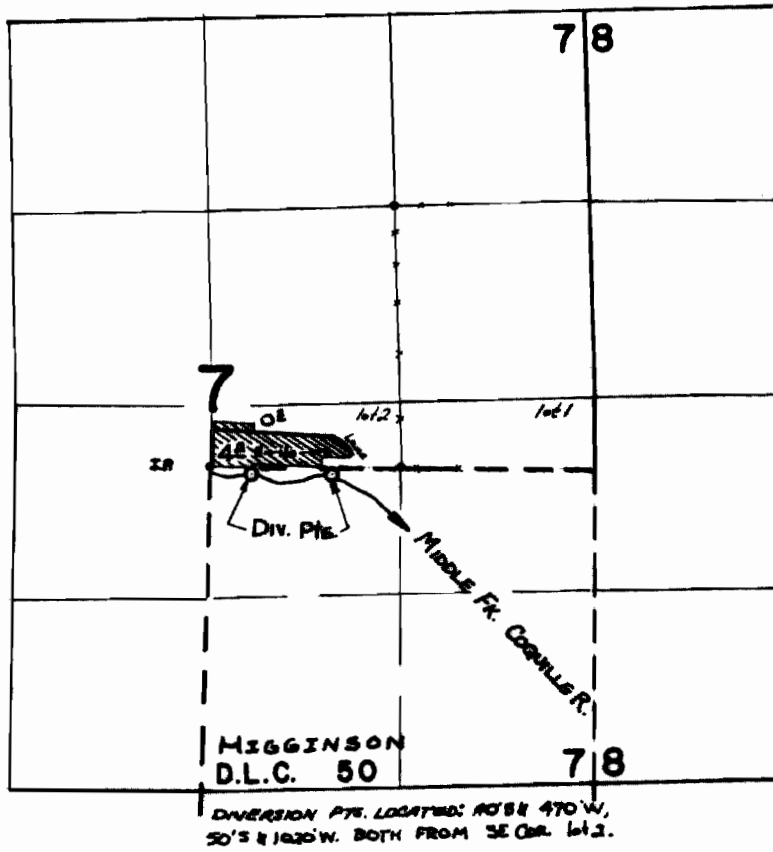

FINAL PROOF SURVEY
UNDER

Application No. 41361..... Permit No. 30897....
IN NAME OF

MR. & MRS. RAY DANCER

Surveyed 10 SEPT 1969, by W. J. RUPPERT

W. J. RUPPERT